

CERTIFIED RECORD OF LAND CORNER MONUMENTATION


N-19

History of original corner establishment:

Corner established by Edward W. Sanderson under GLO contract No. 368 in September of 1880.

Set a stone 15x10x8 in stone mound from which:

- A Pine 6" dia. bears S 45°E 10 lks.
- A Pine 6" dia. bears N 30°E 15 lks.

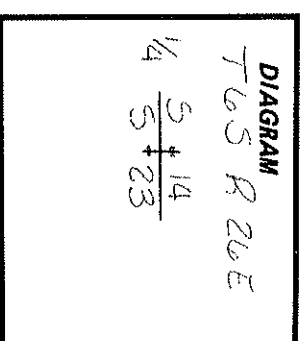

Description of corner evidence found:

Found stone 15"x10"x8" standing upright in ground in stone mound. No scribing was found on the stone. No trees were found, but the face of one of the BT's was lying beside the stone in a mound. Scribing was clearly visible: $\frac{1}{4}$ S BT.

Description of monument and accessories I established to perpetuate the original location of this corner:

Set a 2½" Brass Cap on a 2½" x 30" Galvanized Iron pipe set 27" in ground, mkd as shown:
From which:


- A 10" Pond. Pine bears S 84°W 19.3 ft.
- A 16" Pond. Pine bears N 21°30'E 28.8 ft.

Blazes are painted red, trees have a red band painted around them and have signs number 54-3, 54-4 and Brass Washers stamped PLS 933 nailed to them.

Bearings were run with a staff compass set at a declination of 20° East, distances were measured with a steel tape to the center of the tree.

October 25, 1983

By: Rod Punches
Witness: Brent Reynolds

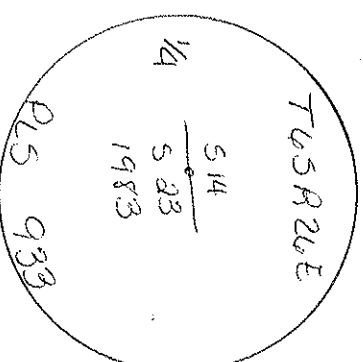

Office of..... SURVEYOR..... County of..... MORTW
 State of..... Oregon....., I hereby certify that the within instrument was filed in this office
 for record on the..... day of....., 19.....
 (COUNTY OFFICIAL)..... by..... (DEPUTY)

Form R6-7100-57 (9/71)

RECEIVED BY
Mortw County Surveyor

Date 10-27-83

Rec'd by HCD

No. A-636-K