


CERTIFIED RECORD OF LAND CORNER MONUMENTATION

Index No. R-21

History of original corner establishment:

The corner was originally established by Edward W. Sanderson under contract No. 368 dated September 7, 1880. The original notes state that at the corner a 13" x 10" x 6" stone was set in a mound of stone from which:
 a 30" pine bears N 20° W 20 LKS (13.2 feet)
 an 18" pine bears S 40° E 75 LKS (49.5 feet)

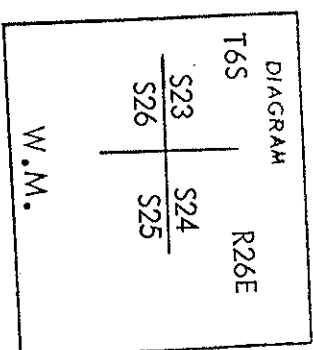

No record of subsequent remonumentation found in County Records.
 Description of corner evidence found:

A 23" bull pine bears S 40° E 49.5 feet with mostly heeled blaze.

Description of monument and accessories established to perpetuate the

original location of this corner
 At the corner position a 2 inch by 30 inch iron pipe, with brass cap marked as shown, was set 12 inches in the ground and surrounded with a mound of stones to the cap.


Set steel fence post north of corner on property line and attached sign 54-4.
 Established 3 new BT's: (original BT in SE quadrant re-used)
 A 6" juniper bears S 89° W, 155.1 feet scribed T6S R26E S26 BT.
 A 9" bull pine bears N 62½° E, 48.2 feet scribed T6S R26E S24 BT.
 A 29" juniper bears N 63° W, 187.5 feet scribed T6S R26E S23 BT.
 New BT's have a lower blaze scribed BT with a brass washer stamped PLS 1106 nailed flush.
 Attached signs 54-3 and 54-4 to all BT's and painted red ring around the trees above the upper blaze.

Used steel tape and magnetic compass with 19½° east declination. Measured to center of Bts.
 See map of survey.

This corner set August 30, 1979

Witnesses:
 D. Kaufman, PLS
 G. Flowers, LSIT
 D. Amort
 B. J. Reynolds

REGISTERED PROFESSIONAL LAND SURVEYOR
<i>William R. Wells</i>
OREGON JULY 22, 1977 WILLIAM R. WELLS 1106

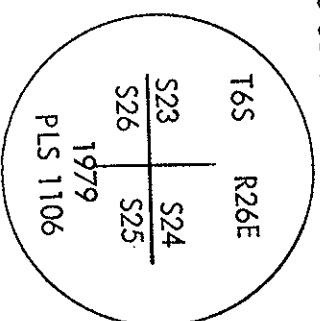

County Surveyor _____ County of Morrow
 Office of Oregon, I hereby certify that the within instrument was filed in this office
 State of _____, day of _____ by _____ (DEPUTY)
 for record on the _____ day of _____ (COUNTY OFFICIAL)

RECEIVED BY
 Morrow County Surveyor
 Date 10-9-79
 Rec'd By [Signature]
 No. # 253-K