


CERTIFIED RECORD OF LAND CORNER MONUMENTATION

Index No. T-17

History of original corner establishment:
The corner was originally established by Edward W. Sanderson under Contract No. 368 dated September 7, 1880. The original notes state that at the corner a 14" x 14" x 12" stone was set in a stone mound from which:
A 36" pine bears west 148 LKS (97.7 feet)

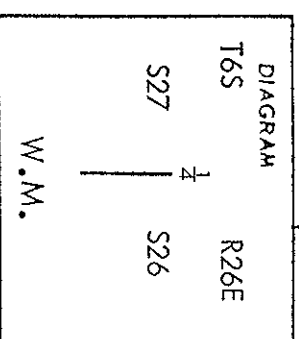

No record of subsequent remonumentation found in County Records .
Description of corner evidence found:

Found a 14" x 14" x 12" stone with "X" chiseled on north face in stone mound.

From which:

A 38" pine stump bears S 84° E, 80.8 feet with no signs of a blaze.

Note: There is an apparent error in the call distance to the bearing tree.

The position of the stone found was verified by survey and then accepted as the 1/4 corner. The position of the stone accepted is 4.24 feet north and 1.71 feet east of the computed position for the 1/4 corner.

Description of monument and accessories established to perpetuate the original location of this corner

At the corner position a 2 inch by 30 inch iron pipe, with brass cap marked as shown, was set 12 inches in the ground and surrounded with a mound of stones to the cap. Set steel fence on section line north of corner and attached signs 54-2 and 54-4.

Established 2 new BT's:

A 12 1/2" bull pine bears N 10 1/2° W, 30.2 feet scribed 1/4 S 27 BT.

A 12" bull pine bears N 75° E, 22.7 feet scribed 1/4 S 26 BT.

New BT's have a lower blaze scribed BT with a brass washer stamped PLS 1106 nailed flush.

Attached signs 54-3 and 54-4 to all BT's and painted red ring around the trees above upper blaze.

Location poster is nailed to a tree on west side of Road #22 0.25 mile ± south of Government Springs. Corner is 700 feet ± west of location poster.

Used steel tape and magnetic compass with 19 1/2° east declination. Measured to center of Bts.
See map of survey.


This corner set September 6, 1979.

Witnesses: G. Flowers, LSIT
B. J. Reynolds

REGISTERED
PROFESSIONAL
LAND SURVEYOR

William R. Wells

OREGON
JULY 22, 1977
WILLIAM R. WELLS
1106

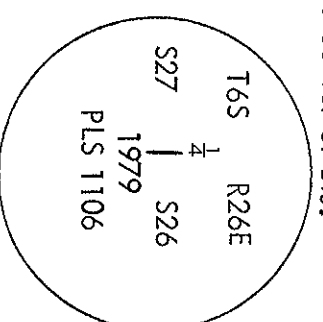

Office of Morrow County Surveyor
State of Oregon, I hereby certify that the within instrument was filed in this office for record on the _____ day of _____, 1979.
(COUNTY OFFICIAL) by _____ (DEPUTY)

RECEIVED BY

Morrow County Surveyor

Date 10-9-79

Rec'd By *W.R.J.*

No. ~~10-9-79~~ 2353-K