


CERTIFIED RECORD OF LAND CORNER MONUMENTATION

Index No. V-17

DIAGRAM

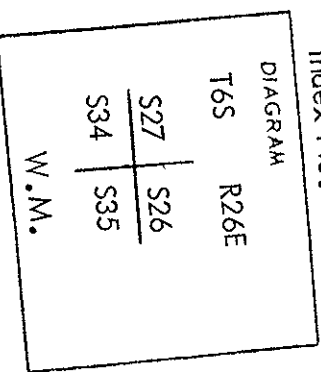

History of original corner establishment:
 The corner was originally established by Edward W. Sanderson under Contract No. 368 dated September 7, 1880. The original notes state that at the corner a stone 18" x 12" x 7" was set in a stone mound from which:
 A 30" pine bears S 70° W 109 Lks (71.9 feet)
 An 18" pine bears N 58° W 142 Lks (93.7 feet)

No record of subsequent remonumentation found in County Records.
 Description of corner evidence found:

Found remains of small mound of stones from which:
 A rotted stump hole bears S 51° W 71.9 feet +.
 A down and rotted pine (mostly cut up for firewood) bears N 59° W 92.5 feet to stump hole.
 Note: There has been a hunter camp here and BT's have been cut for firewood and some stones from mound used for campfire ring.

Description of monument and accessories established to perpetuate the original location of this corner
 At the corner position a 2 inch by 30 inch iron pipe, with brass cap marked as shown, was set 10 inches in the ground and surrounded with a mound of stones to the cap.
 Set steel fence post north of corner and attached signs 54-4 and 54-2.

Established 4 new BT's:
 A 9 1/2" bull pine bears N 30 1/2° W 70.2 feet scribed T6S R26E S27BT.
 A 9 1/2" bull pine bears N 68 1/2° E 146.7 feet scribed T6S R26E S26BT.
 A 9 1/2" bull pine bears S 40 1/2° E 196.6 feet scribed T6S R26E S34BT.
 A 10" bull pine bears S 43 1/2° W 45.5 feet scribed T6S R26E S34BT.
 New BT's have a lower blaze scribed BT with a brass washer stamped PLS 1106 nailed flush.
 Attached signs 54-3 and 54-4 to all BT's and painted red ring around the trees above upper blaze.
 Measured to center of Bts.

Used steel tape and magnetic compass with 19 1/2° east declination.
 See map of survey.


This corner set September 5, 1979.

Witnesses:
 G. Flowers, LSIT
 B. J. Reynolds

REGISTERED
 PROFESSIONAL
 LAND SURVEYOR

William R. Wells

OREGON
 JULY 22, 1977
 WILLIAM R. WELLS
 1106

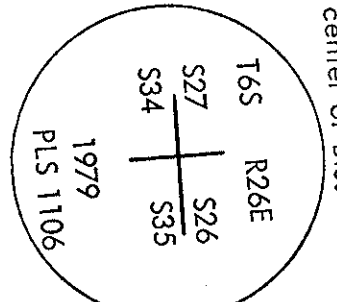

County of MORROW
 Office of Oregon, I hereby certify that the within instrument was filed in this office
 State of Oregon, I hereby certify that the within instrument was filed in this office
 for record on the day of by (DEPUTY)
 (COUNTY OFFICIAL)

RECEIVED BY
Morrow County Surveyor
 Date 10-9-79
 Rec'd By WRS
 No. #258-X