

X-25

# OREGON CORNER RESTORATION FORM

COUNTY: Morrow. DATE: 06/24/11

CORNER DESIGNATION: X-25, The East One-Quarter corner of Section 36, Township 6 South, Range 25 East, W.M..

PREVIOUS RENEWALS/SURVEYS ETC: Corner originally established by E. W. Sanderson under Contract No. 368 dated September 7, 1880. Notes state: Set stone 18x12x6 in stone mound for 1/4 sec. cor. from which a pine 20 in. dia. bears S 25° E, 10 lks., a pine 10 in. dia. bears N 12° W, 11 lks.

MONUMENT AND ACCESSORIES FOUND: Found a 20"x12"x6" set stone in a 2 1/2' dia. mound of stone. No marks found on stone. A 28" ponderosa pine stump with open blaze and fragmented scribes visible bears North 12° West, a distance of 26.9 feet to the face of blaze and 27.4 feet to the tree centerline. A 30" ponderosa pine with open blaze and scribes visible bears South 25° East a distance of 2.6 feet to the face of blaze, and 3.7 feet to the tree centerline.

## MONUMENT MARKING DETAIL:

T6S  
R25E | R26E  
1/4 S36 |  
2011  
PLS 54657

MONUMENT SET: At position of found stone set a 1/2" brass cap on 1 1/4"x30" galvanized iron pipe 29" in the ground and surround with stones and earth. Cap is marked as shown in "Monument Marking Detail". Placed corner stone on East side of new monument.

### New accessories:

- A 7" douglas fir scribed 1/4 S36 BT on single blaze bears South 52° West, 40.7 feet to tree centerline.
- A 4" ponderosa pine scribed "X" at breast height and "BT" at base bears North 30° West, 46.0 feet to tree centerline.
- A 7" douglas fir scribed 1/4 S36 BT on single blaze bears North 84° West, 14.4 feet to tree centerline.

Attached bearing object signs to all live bearing trees. Attached witness sign facing West to the original 30" ponderosa pine bearing tree.

LOCATION AND COMMENTS: Corner is located 2 feet East of a fence running North-South, on a East slope. There is a old Kinzua Lumber K tag on the live original 30" ponderosa pine bearing tree.


STATE PLANE COORDINATE, NAD 83(CORS96)(EPOCH 2002.00), International Feet:  
North = 488083.21  
East = 8417559.22

FIRM: Wells Surveying  
P.O. Box 1696  
Pendleton, OR 97801

COMPASS DECLINATION: 18° East Surveyor's Seal

Witnesses: William R. Wells, PLS

\6S25X25

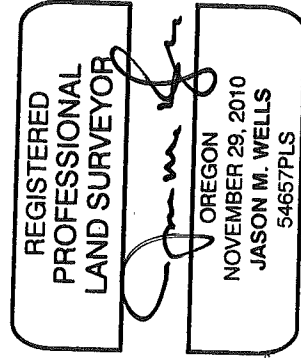

RENEWS: 6/30/12