


CERTIFIED RECORD OF LAND CORNER MONUMENTATION

Index No. X-17

History of original corner establishment:

The corner was originally established by Edward W. Sanderson under Contract No. 368 dated September 7, 1880. The original notes state that at the corner a 15x12x6" stone was set in stone mound from which:
A 20" pine bears S75° W 68 Lks (44.9 ft)

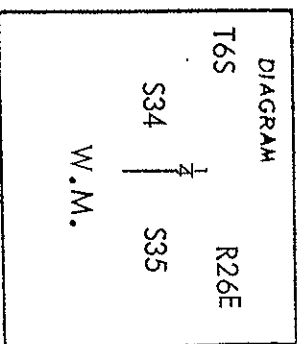

No record of subsequent remonumentation found in County Records .
Description of corner evidence found:

Found a rough volcanic stone in stone mound on south slope.

From which:

A 34" pine stump bears N35½° W 44.9 feet. The stump is 4' high and blazed and scribed ½S.

*Note: There is an apparent error in the original call of S75° W. The stone found bears S35½° E from BT. The stone found fits line and BT blazes. The original call of S75° W 44.9 ft. falls at the base of a 12" Juniper.

Description of monument and accessories I established to perpetuate the original location of this corner

At the corner position a 2 inch by 30 inch iron pipe, with brass cap marked as shown, was set 6 inches in the ground and surrounded with a mound of stones to the cap.

Set steel fence post on section line south of corner and attached signs 54-2 and 54-4.

Established 2 new BT's:

A 9½" Juniper bears N 77° W 57.0 feet scribed ¼ S 34 BT.

A 10" Bull Pine bears S 75° E 33.7 feet scribed ¼ S 35 BT.

New BT's have a lower blaze scribed BT with a brass washer stamped PLS 1106 nailed flush.

Attached signs 54-3 and 54-4 to all BT's and painted red ring around the trees above upper blaze.

Used steel tape and magnetic compass with 19½° east declination. Measured to center of Bts.
See map of survey.


This corner set September 6, 1979

Witnesses: G. Flowers, LSIT
B. J. Reynolds

REGISTERED
PROFESSIONAL
LAND SURVEYOR

William R. Wells

OREGON
JULY 22, 1977
WILLIAM R. WELLS
1106

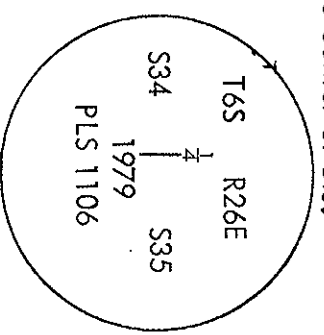

Office of County Surveyor Morrow County of Morrow
State of Oregon, I hereby certify that the within instrument was filed in this office
for record on the day of 1979
 (COUNTY OFFICIAL) by (DEPUTY)

RECEIVED BY

Morrow County Surveyor

Date 10-9-79

Rec'd By Wm R Wells

No. # 253-K