


7-15

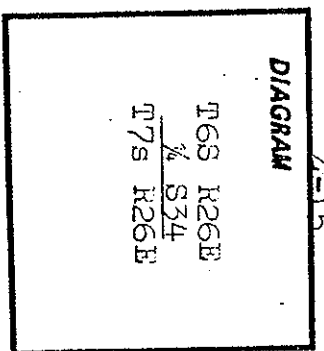

History of original corner establishment:  
Edward W. Sanderson, under G.L.O. contract number 368, dated Sep. 7, 1880, set a stone 18"X 12"X 9" in a stone mound.

Description of corner evidence found:  
None.

Description of monument and accessories | established to perpetuate the original location of this corner:  
At proportionate distance I set a 2 1/2"X 30" alum. pipe with a 3" alum. cap containing a magnet and marked:

T6S R26E  
1/4 S34  
T7S R26E  
P1S 1832  
1985

From which:  
A Douglas Fir, 11" dia., N81°W, 75.2 ft.; marked: 1/4 S34 BT  
A Ponderosa Pine, 8" dia., N22°W, 29.2 ft.; marked: 1/4 S34 BT  
BTs have blaze and a 6" stripe painted red, a BT tag, an "Attention" sign and an alum. "P1S 1832" washer nailed to the bottom of the blaze. There is a 6' steel fence post with an "Attention" sign within 5' of the corner.  
Measured to center of BTs using steel tape and staff compass. Magnetic declination set a 17 1/2°E.

September 3, 1985

REGISTERED  
PROFESSIONAL  
LAND SURVEYOR  
*Fayette S. Munro*  
OREGON  
JULY 13, 1979  
FAYETTE S. MUNRO  
1832

Office of.....*Surveys*..... County of.....*Harrow*.....  
State of.....*Oregon*..... I hereby certify that the within instrument was filed in this office  
for record on the.....*24*..... day of.....*December*....., 1985  
.....*David A. K...*..... by .....  
(COUNTY OFFICIAL) (DEPUTY)