


CERTIFIED RECORD OF LAND CORNER MONUMENTATION

Index No. Z-17

History of original corner establishment:

The corner was originally established by Edward W. Sanderson under Contract No. 368 dated September 7, 1880. The original notes state that at the corner an 18" x 12" x 6" stone was set in a mound of stone from which:
 A 30" pine bears S 22° E 65 LKS (42.9 feet)

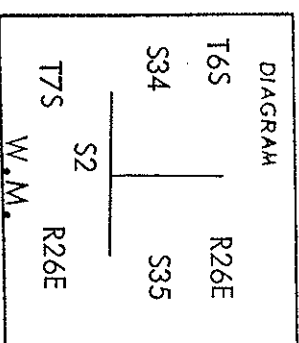

No record of subsequent remonumentation found in County Records .

Description of corner evidence found:

Found 18" x 12" x 6" stone marked $\frac{26}{26}$ in stone mound.

from which: A 42" pine with partly healed blaze and visible scribing bears S 25° E 46.2 feet.

A 10" juniper with line blazes and location tag bears N 12° W 4.3 feet.

(This is not an original BT)

Description of monument and accessories established to perpetuate the original location of this corner

At the corner position a 2 inch by 30 inch iron pipe, with brass cap marked as shown, was set 11 inches in the ground and surrounded with a mound of stones to the cap. Buried stone monument beside cap.

Set steel fence posts north and west of corner on section lines and attached signs 54-2 and 54-4.

Established 2 new BT's: (old BT in Section 2 re-used)

A 14" juniper bears N 5° W 20.4 feet scribed T6S R26E S34BT.

A 12" juniper bears N 72½° E 36.1 feet scribed T6S R26E S35BT.

New BT's have a lower blaze scribed BT with a brass washer stamped PLS 1106 nailed flush.

Attached signs 54-3 and 54-4 to all BT's and painted red ring around the trees above the upper blaze.

Used steel tape and magnetic compass with 192° east declination. Measured to center of Bts.

See map of survey .

This corner set September 5, 1979.


REGISTERED PROFESSIONAL LAND SURVEYOR

Witnesses: G. Flowers, LSIT

William R. Wells

B. J. Reynolds

OREGON JULY 22, 1977 WILLIAM R. WELLS 1106

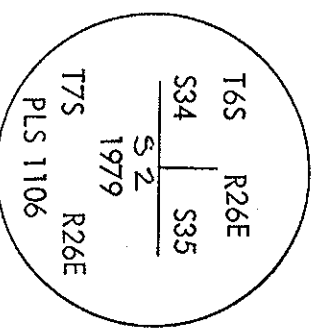

Office of County Surveyor Morrow County of Morrow
 State of Oregon, I hereby certify that the within instrument was filed in this office
 for record on the day of 19
 (COUNTY OFFICIAL) by (DEPUTY)

RECEIVED BY

Morrow County Surveyor

Date 10-9-79

Rec'd By W.R.

No. #253-K