

CERTIFIED RECORD OF LAND CORNER MONUMENTATION

2-5


History of original corner establishment:

This corner was established in 1880 by Edward W. Sanderson, under General Land Office Contract No. 368

Surveyor General's records state:

Set stone 20 x 13 x 4 in a stone mound for corner, from which

- A Pine 30" dia. bears North 30° West, 143 links
- A Pine 24" dia. bears North 32° East, 120 links
- A Pine 10" dia. bears South 35° East, 160 links

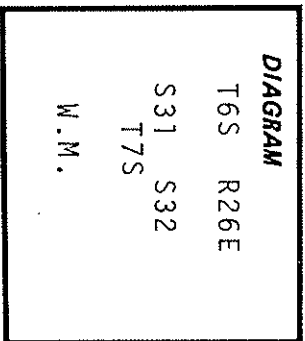


Description of corner evidence found:

Found a stone of comparable size, but with no discernable marks in a mound of stone from which I found the following original accessories:

- A P. Pine stump 38" dia. with scribe marks "BT" in open blaze bears North 32° East 79.20 feet to face of blaze (record North 32° East 79.2 feet)
- A dead and down P. Pine 28" dia., with scribe marks T6S R26E S31 in open blaze, the roothole of which bears North 3° West 26.2 feet (record North 30° West 94.4 feet)

Description of monument and accessories I established to perpetuate the original location of this corner:

I set a 2" x 30" flanged G.I. Pipe with a 2-1/2" Brass Cap exposed 16" in a mound of stone marked:

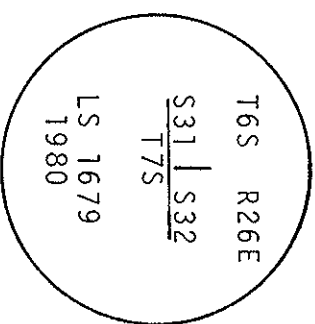

I take the following bearing trees and take the measurements to the center of the tree at the lower blaze in which I place a brass washer stamped LS 1679

- P. Pine 11" dia. bears North 23-1/4° East 25.5 feet mkd T6S R26E S32 BT
- P. Pine 13" dia. bears South 9-1/2° West 30.3 feet mkd T7S R26E S5 BT
- P. Pine 7" dia. bears North 31-1/2° West 41.1 feet mkd T6S R26E S31 BT

I hereby certify the above corner monument was re-established as herein described on November 6, 1980.

Witness: Bob Malotte
Mag. Var. 19° East

REGISTERED
PROFESSIONAL
 LAND SURVEYOR
Kurt C. Weaver
 OREGON
 JULY 14, 1978
 KURT C. WEAVER
 1679

Office of Surveyor County of MORROW
 State of Oregon
 for record on the 16th day of January, 1981
David H. Klein by (DEPUTY)
 (COUNTY OFFICIAL)

Form R6-7100-57 (9/71)

RECEIVED BY
 Morrow County Surveyor's
 Date August 7 1981
 Rec'd By M. Hughes
 No. 488-K

*GPO—798-276