

Record of Land Corner Monumentation

Section 32-33 Township 06S Range 26E Code T6S R26E Z09

County Morrow Date August 18, 2013

History of Original Corner Establishment:

The Original Monument was established in 1881 by E.W. Sanderson in an Original GLO Survey of Township 6 South Range, 26 East under Contract No. 368. A. F. York completed the North boundary of Township 7 South, Range 26 East in 1878. Sanderson retraced York's line and set the South monuments for this township on York's line.

Sanderson's Notes: Set 16x12x4 Stone in Stone Mound
A Pine 36" in Ø bears N 55° E 175 lks
A Pine 10" in Ø bears N 12° W 160 lks

Description of evidence found:

Found 2 of 2 original Bearing trees as decribed in Sanderson's notes for this Section Corner. Used the distances in Sanderson's notes to reestablish the location of the corner. No other evidence found.

Found Original BT (18" Ø rotted stump w/ 16" x 50" portion of log adjacent w/ scribes inside the log) N 13° 32' W 105.6 feet of set Monument.

Found Original BT (Apparent 44" - Ø burned out stump & pit closey matches location of Orig. BT) N 54° 50' E 115.5 feet of set Monument


Description of monumentation and accessories established to perpetuate the location of this Section Corner:

Used the distances in Sanderson's notes to reestablish the location of the corner. Set 2 1/2" Brass Cap on 1" Iron Pipe with flat stones arranged around the brass cap with a steel fence post and monument sign set just to the south of the cap.

In addition, the following Bearing Trees were Blazed, Scribed, and tagged with placards as follows:

- 1 - A 26" Ø Ponderosa Pine bears N 23° 00' E 125.1 feet. Scribed "6S 26 S33 BT"
- 2 - A 40" Ø Ponderosa Pine bears N 84° 52' E 131.8 feet. Scribed "6S 26 S33 BT"
- 3 - A 10" Ø Ponderosa Pine bears S 40° 03' W 373.8 feet. Scribed "6S 26 S32 BT"
- 4 - A 10" Ø Ponderosa Pine bears N 43° 01' W 293.3 feet. Scribed "6S 26 S32 BT"

All directions on placards are given to the set monument.

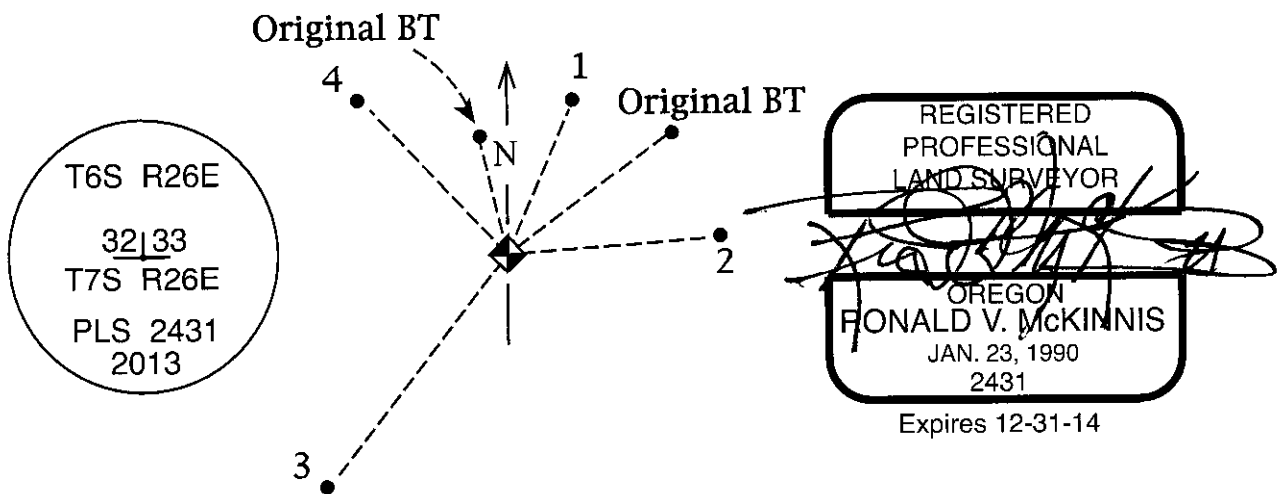

Office of Surveyor County of Morrow
 State of Oregon I hereby certify that the within instrument was
 filed in this office for record on the 15th day of April, 2014
John K. Hubbard by _____
 (COUNTY OFFICIAL) (DEPUTY)

Survey Number 2014-1697D