

CERTIFIED RECORD OF LAND CORNER MONUMENTATION

T6S, R27E


Refer to: Plat of Stahl 1990 Cadastral Survey  
Sections 4 and 8, T.6S., R.27E., W.M.

A-9

History of original corner establishment:

Edward W. Sanderson under G.L.O. contract no. 368,  
dated Sep. 7, 1880, set a stone 15"x 7"x 6" in a  
mound of stone from which:

- A Fir, 14" dia., N200E, 23 lks.
- A Fir, 16" dia., S580E, 20 lks.
- A Fir, 12" dia., S250W, 16 lks..

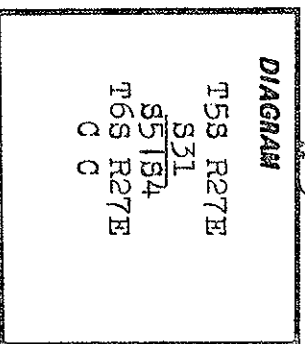

Description of corner evidence found:

I found a stone 15"x 7"x 6" firmly set with no marks apparent. Squared  
off wood post set in ground approx. 1' N. Post scribed T6S R27E S5  
on SW face and T6S R27E S4 on SE face. I found no record of this post.  
From the original stone:

- A White Fir, dying, 23" dia., S400W, 9.8 ft.;
- open blaze, no scribing visible.
- A badly rotted stump S550E, 15.8 ft.; no scribing visible.
- A root hole, N160E, 15.2 ft.

Description of monument and accessories | established to perpetuate the  
original location of this corner:


At the true intersection point established by survey (refer to plat),  
I set a 2 1/2"x 30" alum. pipe with a 2 1/2" alum. cap mkd.:  
Monument is 24" in the ground and surrounded  
by a small stone mound.

T5S R27E  
S31  
S51S4  
T6S R27E  
C C  
PLS 1832  
1990

The original stone left in place, S040°W, 0.61 ft.  
5/8"x 30" rebar driven 26" in ground, S77 3/4°E, 10.0 ft.  
with yellow plastic "PLS 1832" cap.  
6' steel fence post driven in ground with "Land Survey  
Monument" sign attached bears West, 4.0 ft.  
A white Fir, 27" dia., S20W, 35.2 ft.; mkd.: T6S R27E S5 CC BT  
A western Larch, 23" dia., S230E, 54.4 ft.; mkd.: T6S R27E S4 CC BT  
BTs have blaze and a 6" band painted red, BT tags and "Land Survey  
Monument" signs. New BTs have, additionally, alum. "PLS 1832"  
washers nailed to the bottom of the blaze.

Measured to center of BTs using steel tape and staff compass. Magnetic  
declination set at 190E.

Sep. 13, 1990

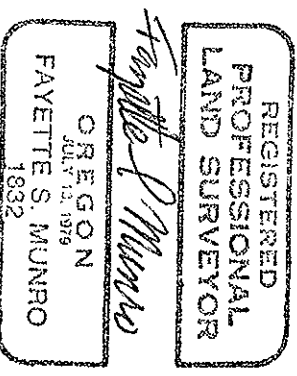

Office of..... County of.....

State of..... I hereby certify that the within instrument was filed in this office

for record on the..... day of....., 19.....

..... by ..... (DEPUTY)

(COUNTY OFFICIAL)

Form R6-7100-57 (9/71)

RECEIVED BY  
Morrow County Surveyor

Date 11/91  
 Rec'd by AOE  
 No. C-904 A-9