


CERTIFIED RECORD OF LAND CORNER MONUMENTATION

C-9

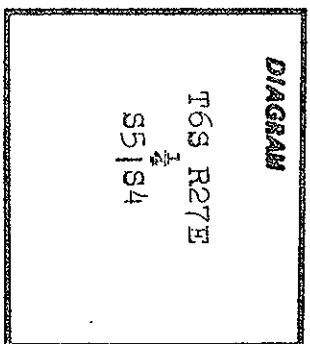

History of original corner establishment:
Edward W. Sanderson subdivided T.6S., R.27E. under G.L.O. contract no. 368, dated Sep. 7, 1880. He set a stone, 20"x 12"x 4" in a stone mound from which:
A Pine, 28" dia., S60°E, 70 lks.
A. Joseph Garrison, Cadastral Surveyor, under Special Instructions, Group No. 1000, dated July 13, 1979, found the orig. stone, 18"x 16"x 4" mkd. as: $\frac{1}{4}$ on W. face. At the corner point he set a 2 $\frac{1}{2}$ " x 28" alum. post with an alum. cap mkd. as:
From the corner:
A Pine, 33" dia., S60°E, 70 lks.;
 scribing visible. (orig. BT)
A Pine, 16" dia., S71 3/4°W, 24 $\frac{1}{2}$ lks. (new BT)


T6S R27E
 $\frac{1}{4}$
S51S4
1982

Description of corner evidence found:

I found a 2 $\frac{1}{2}$ " alum. pipe with a 3 $\frac{1}{4}$ " alum. cap mkd. as above.
From the corner:
A Ponderosa Pine, 34" dia., S60°E, 46.2 ft.; scribing visible.
A Ponderosa Pine, 16" dia., S71 3/4°W, 16.2 ft.; scribing visible.

Description of monument and accessories I established to perpetuate the original location of this corner:

I marked new BTs:
A Douglas Fir, 16" dia., N24°W, 36.0 ft.; mkd. as: $\frac{1}{4}$ S5 BT
A Douglas Fir, 11" dia., S48 $\frac{1}{2}$ °E, 19.6 ft.; mkd. as: $\frac{1}{4}$ S4 BT
BTs have blaze and a 6" band painted red, BT tags and "Land Survey Monument" signs. New BTs have, additionally, alum. "PLS 1832" washers nailed to the bottom of the blaze. There is a 6" steel fence post with a "Land Survey Monument" sign within 5' of the corner.
Measured to center of BTs using steel tape and staff compass. Magnetic declination set at 20°E.
Sep. 13, 1990

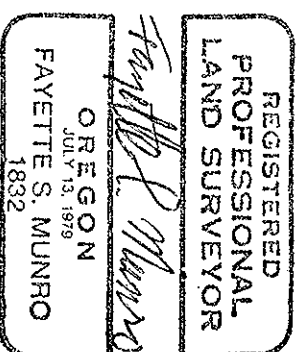

Office of..... County of.....
State of..... I hereby certify that the within instrument was filed in this office
for record on the..... day of....., 19.....
..... by
(COUNTY OFFICIAL) (DEPUTY)

RECEIVED BY
Morrow County Surveyor
Date 11/91
Rec'd By [Signature]
No. E-904 E-9

Form R6-7100-57 (9/71)