


CERTIFIED RECORD OF LAND CORNER MONUMENTATION

Refer to: Plat of Stahl 1990 Cadastral Survey

E-7

History of original corner establishment:

Edward W. Sanderson under G.L.O. contract no. 368,
dated Sep. 7, 1880, set a stone 14"x 10"x 5" in
a mound of stone from which:
A Pine, 20" dia., S65°0W, 24 lks.
A Pine, 30" dia., S65°0E, 24 lks.

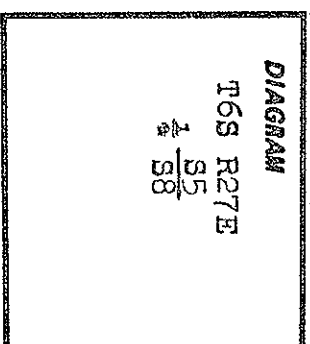

Description of corner evidence found:

I found a stone 14"x 8"x 5" mkd. $\frac{1}{4}$. Stone was broken; bottom part
was firmly set.
From the corner point established at the location of bottom part of
original stone:

A Ponderosa Pine, 32" dia., N12 $\frac{1}{2}$ °0W, 13.4 ft.; with scribbling visible.
A Ponderosa Pine, uprooted, lying face down, size indeterminate;
the root hole of which bears S65°0W, 15.8 ft.


**Description of monument and accessories | established to perpetuate the
original location of this corner:**

At the corner point I set a 2 $\frac{1}{2}$ "x 30" alum. pipe with a 2 $\frac{1}{2}$ " alum. cap
mkd.:

Monument is 25" in the ground with original
stone buried alongside.
From the corner:
T6S R27E
PLS 1832
1990

6' steel fence post driven in ground with "Land Survey
Monument" sign attached; bears S81 $\frac{1}{2}$ °0W, 4.5 ft.
A Ponderosa Pine, 10" dia., N51°0W, 32.5 ft.; mkd.: $\frac{1}{4}$ S5 BT
A Ponderosa Pine, 13" dia., S15 $\frac{1}{4}$ °0W, 87.6 ft.; mkd.: $\frac{1}{4}$ S8 BT
BTs have blaze and a 6" band painted red, BT tags and "Land Survey
Monument" signs. New BTs have, additionally, alum. "PLS 1832"
washers nailed to the bottom of the blaze.
Measured to center of BTs using steel tape and staff compass, Magnetic
declination set at 19°E.

Sep. 15, 1990

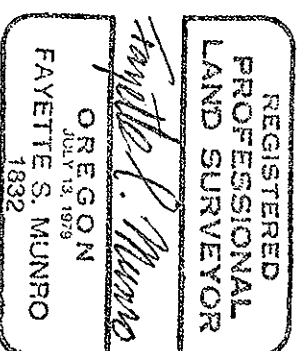

Office of..... County of.....
State of..... I hereby certify that the within instrument was filed in this office
for record on the..... day of....., 19.....

(COUNTY OFFICIAL)

RECEIVED BY

(DEPUTY)

Form R6-7100-57 (9/71)

Morrow County Surveyor

Date

1/91

Rec'd By

[Signature]

No.

R-904 E-7