

History of original corner establishment:

A. Joseph Garrison, Cadastral Surveyor, under Special Instructions, Group No. 1000, dated July 13, 1979, located the corner from the orig. BTs. He set a 2 1/2" x 28" alum. post with an alum. cap mkd. from the corner;

A Fir snag, 28" dia., S65°E, 10 lks.; no scribing. (orig. BT)

A Pine, 36" dia., S77 3/4°W, 30 lks.; scribing visible. (orig. BT)

A Fir, 23" dia., N13°W, 18 lks.; healed blaze. (orig. BT)


A Pine, 8" dia., N73 1/2°E, 58 1/2 lks. (new BT)

A Pine, 8" dia., S44 1/2°E, 75 1/2 lks. (new BT)

DIAGRAM	
T6S R27E	
S5 S4	
S8 S9	
T6S R27E	
S5 S4	
S8 S9	
1982	

Description of corner evidence found:

Description of monument and accessories | established to perpetuate the original location of this corner:

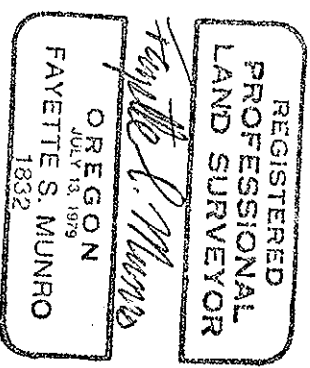

Office of..... County of.....
 State of..... I hereby certify that the within instrument was filed in this office
 for record on the..... day of....., 19.....
 (COUNTY OFFICIAL) by..... (DEPUTY)

Form R6-7100-57 (9/71)

RECEIVED BY
 Morrow County Surveyor

Date 11/91

Rec'd By AD

No. 0-904 E-9

(2 of 2)