

CERTIFIED RECORD OF LAND CORNER MONUMENTATION

Refer to: Plat of Stahl 1990 Cadastral Survey
Sections 4 and 8, T.6S., R.27E., W.M.

F-5

History of original corner establishment:

No record of previous monumentation.

DIAGRAM
T6S R27E
N1/16
S7/138

Description of corner evidence found:

None.

Description of monument and accessories I established to perpetuate the original location of this corner:

At the corner point established by measurement I set a 2 1/2" x 30" alum. pipe with a 2 1/8" alum. cap mkd.: Monument 1s 24" in the ground.

N1/16
S7/138
PLS 1832
1990


From the corner;

A Ponderosa Pine, 15" dia., S83 1/2°E, 66.0 ft.; mkd.: N1/16 S8 BT
A Ponderosa Pine, 14" dia., S23 1/2°W, 25.9 ft.; mkd.: N1/16 S7 BT

BTs have blaze and a 6" band painted red, BT tags, "Land Survey Monument" signs and alum. "PLS 1832" washers nailed to the bottom of the blaze. There is a 6' steel fence post with a "Land Survey Monument" sign within 5' of the corner.

Measured to center of BTs using steel tape and staff compass. Magnetic declination set at 190E.

Sep. 20, 1990

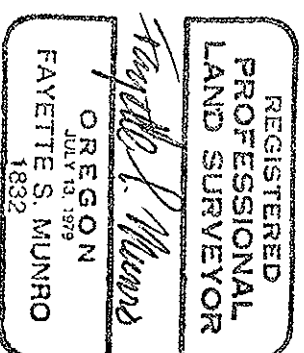

Office of..... County of.....
State of....., I hereby certify that the within instrument was filed in this office
for record on the..... day of....., 19.....
..... by
(COUNTY OFFICIAL) RECEIVED BY (DEPUTY)

Form R6-7100-57 (9/71)

Morrow County Surveyor
Date 11/91
Rec'd By 108
No. C-904 E-5