


CERTIFIED RECORD OF LAND CORNER MONUMENTATION

Refer to: Plat of Stahl 1990 Cadastral Survey
Sections 4 and 8, T.6S., R.27E., W.4M

History of original corner establishment:
No record of previous monumentation.

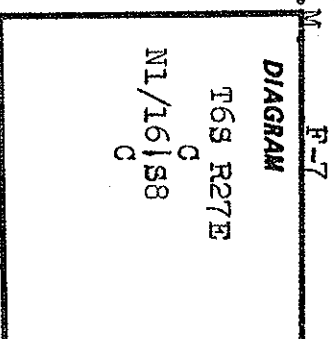

Description of corner evidence found:
None.

Description of monument and accessories I established to perpetuate the original location of this corner:

At the corner point established by measurement I set a 2 1/2" x 30" alum. pipe with a 2 1/2" alum. cap mkd.; Monument is 12" in the ground and surrounded by a mound of stone.

N1/16/58
C
PLS 1832
1990


From the corner:

A Ponderosa pine, 14" dia., S26 1/4° W, 25.6 ft.; mkd.; ON1/16 S8 BT
A Ponderosa pine, 12" dia., S21 3/4° E, 70.4 ft.; mkd.; ON1/16 S8 BT

BTs have blaze and a 6" band painted red, BT tags, "Land Survey Monument" signs and alum. "PLS 1832" washers nailed to the bottom of the blaze. There is a 6' steel fence post with a "Land Survey Monument" sign within 5' of the corner.

Measured to center of BTs using steel tape and staff compass. Magnetic declination set at 19°E.

Sep. 15, 1990

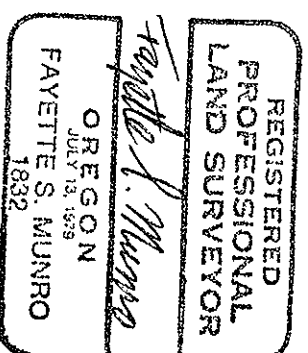

Office of..... County of.....
State of....., I hereby certify that the within instrument was filed in this office
for record on the..... day of....., 19.....

..... by
(COUNTY OFFICIAL) RECEIVED BY (DEPUTY)

Form R6-7100-57 (9/71)

Morrow County Surveyor
Date 11/91
Rec'd By MS
No. C-904 F-7