

CERTIFIED RECORD OF LAND CORNER MONUMENTATION

G-5


History of original corner establishment:

Edward W. Sanderson subdivided T.6S.; R.27E. under G.L.O. contract no. 368, dated Sep. 7, 1880. He set a stone, 14" x 9" x 6" in a stone mound; from which: A Pine, 36" dia., S250W, 40 lks.

A Joseph Garrison, Cadastral Surveyor, under Special Instructions, Group No. 1000, dated July 13, 1979, found the orig. stone, 14" x 8" x 5" mkd.; $\frac{1}{4}$ on W. face. At the cor. pt. he set a 2 $\frac{1}{2}$ " x 28" alum. post with an alum. cap mkd.:

- From the corner;
- A Decayed Pine stump, 27" dia., S23 $\frac{1}{2}$ 0W, 40 lks.; with scribing visible. (orig. BT)
- A Pine, 14" dia., S700E, 57 $\frac{1}{2}$ lks. (new BT)
- A Fir, 24" dia., S740W, 41 lks. (new BT)

T6S R27E
S71 $\frac{1}{2}$ S8
1982

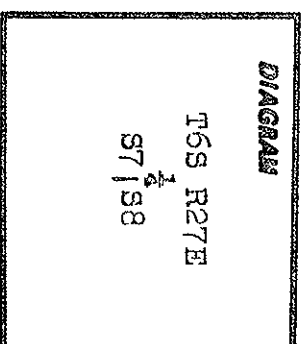

Description of corner evidence found:

- I found a 2 $\frac{1}{2}$ " alum. pipe with a 3 $\frac{1}{2}$ " alum. cap (BIM) mkd. as above. From the corner;
- A Ponderosa Pine, 15" dia.; S700E, 38.0 ft.; with scribing visible.
- A Douglas Fir, 27" dia., S740W, 27.1 ft.; with scribing visible.


Description of monument and accessories | established to perpetuate the original location of this corner:

- I marked a new BT;
- A Ponderosa Pine, 14" dia., N67 3/40W, 70.2 ft.; mkd.; $\frac{1}{2}$ S7 BT
- 6' steel fence post driven in ground with "Land Survey Monument" sign; S88 $\frac{1}{2}$ 0W, 4.4 ft.

BTs have blaze and a 6" band painted red, BT tags and "Land Survey Monument" signs. New BT has, additionally, an alum. "PLS 1832" washer nailed to the bottom of the blaze.

Measured to center of BTs using steel tape and staff compass. Magnetic declination set at 20°E.

AUG. 29, 1990

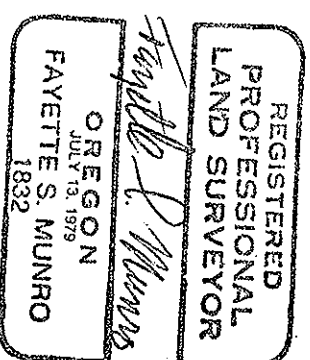

Office of..... County of.....
 State of..... I hereby certify that the within instrument was filed in this office
 for record on the..... day of....., 19.....
 (COUNTY OFFICIAL) by..... (DEPUTY)

Form R6-7100-57 (9/71)

RECEIVED BY

Morrow County Surveyor

Date 11/21

Rec'd By MS

No. E-904 G-5