


CERTIFIED RECORD OF LAND CORNER MONUMENTATION

Refer to: Plat of Stahl 1990 Cadastral Survey
Sections 4 and 8, T.6S., R.27E., W.M.

G-7

History of original corner establishment:
No record of previous monumentation.

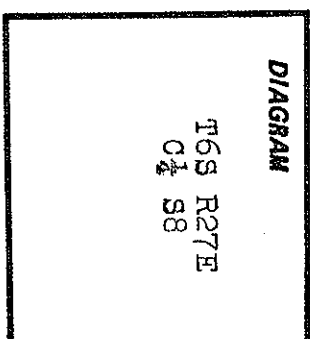

Description of corner evidence found:
None.

Description of monument and accessories I established to perpetuate the original location of this corner:


At the corner point established by measurement, I set a 2 1/2" x 30" alum. pipe with a 2 1/2" alum. cap mkd.:
Monument is 13" in the ground and surrounded by a mound of stone.

T6S R27E
C1/4 S8
PLS 1832
1990

From the corner:

A Ponderosa Pine, 15" dia., S70 1/4 OE, 94.7 ft.; mkd.: C 1/4 S8 BT
 A Ponderosa Pine, 17" dia., N73 1/2 OE, 109.7 ft.; mkd.: C 1/4 S8 BT
 Wood power pole no. 531 in power line to Tupper W.C., 11" dia., N33 OE, 143.6 ft.
 6' steel fence post with "Land Survey Monument" sign, S67 OE, 4.4 ft.
 BTs have blaze and a 6" band painted red, BT tags, "Land Survey Monument" signs and alum. "PLS 1832" washers nailed to the bottom of the blaze.
 Measured to center of BTs using steel tape and staff compass. Magnetic declination set at 19 OE.

Sep. 14, 1990

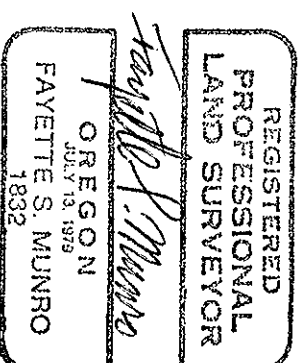

Office of..... County of.....
 State of....., I hereby certify that the within instrument was filed in this office
 for record on the..... day of....., 19.....
 by.....
 RECEIVED BY (DEPUTY)

Form R6-7100-57 (9/71)

Morrow County Surveyor
 Date 11/91
 Rec'd By MLB
 No. R-904 G-7