


History of original corner establishment:
 Edward W. Sanderson subdivided T.6S., R.27E. under G.L.O. contract no. 368, dated Sep. 7, 1880. He set a stone 12"x 10"x 6" in a stone mound, from which:
 A Pine, 24" dia., S10°E, 200 lks.

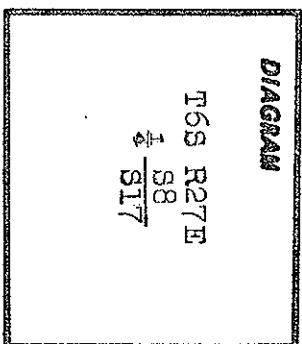

A Joseph Garrison, Cadastral Surveyor, under Special Instructions, Group No. 1000, dated July 13, 1979, found the orig. stone 12"x 8"x 6" mkd. 1/4 on N. face. At the corner point he set a 2 1/2"x 28" alum. post with an alum. cap mkd. ;
 From the corner:
 A Pine snag, 35" dia., S10°E, 200 lks.;
 with scribing visible. (orig. BT)
 A Pine, 15" dia., S20°W, 93 1/2 lks. (new BT)
 A Pine, 15" dia., N49 3/4°W, 69 1/2 lks. (new BT)

T6S R27E
 S8
 1 1/2 BT
 1982

Description of corner evidence found:
 I found a 2 1/2" alum. pipe with a 3 1/2" alum. cap (BLM) mkd. as above.
 From the corner:

A Ponderosa Pine, 17" dia., S20°W, 61.7 ft.; with scribing visible.
 A Ponderosa Pine, 16" dia., N49 3/4°W, 45.9 ft.; with scribing visible.


Description of monument and accessories I established to perpetuate the original location of this corner:
 I marked a new BT:

A Ponderosa Pine, 16" dia., S280°E, 75.1 ft.; mkd.; X at breast height and BT at base.
 6' steel fence post driven in ground with "Land Survey Monument" sign; S880°W, 4.0 ft.

BTs have blaze and a 6" band painted red, BT tags and "Land Survey Monument" signs. New BT has, additionally, an alum. "PLS 1832" washer nailed to the bottom of the blaze.

Measured to center of BTs using steel tape and staff compass. Magnetic declination set at 200E.

Aug. 29, 1990

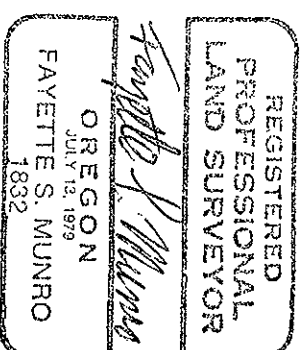

Office of..... County of.....
 State of....., I hereby certify that the within instrument was filed in this office
 for record on the..... day of....., 19.....
 (COUNTY OFFICIAL) by..... (DEPUTY)

RECEIVED BY

Morrow County Surveyor

Date 1/91
 Rec'd By ADP
 No. C-904 J-7