

DIAGRAM

T6S R27E
S8 | S9
S17 | S16

T6S R27E
S8 | S9
S17 | S16
1982


History of original corner establishment:

A. Joseph Garrison, Cadastral Surveyor, under Special Instructions, Group No. 1000, dated July 13, 1979, located the corner from the remaining BTs. He set a 2 1/2" x 28" alum. post with an alum. cap mkd. from the corner;

- A Pine, 33" dia., S46°0E, 117 lks.; scribing visible. (orig. BT)
- A Pine, 28" dia., N62°0W, 45 lks.; scribing visible. (orig. BT)
- Orig. NE BT, down Pine, 12" dia.;
- orig. location not found.
- Pine, 9" dia., N31°0E, 108 lks. (new BT)
- Pine, 12" dia., S54 1/2°0W, 58 lks. (new BT)

Description of corner evidence found:

Description of monument and accessories | established to perpetuate the original location of this corner:

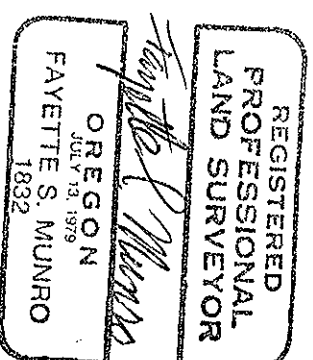

Office of..... County of.....
 State of..... I hereby certify that the within instrument was filed in this office
 for record on the..... day of....., 19.....
 by (DEPUTY)
 (COUNTY OFFICIAL)

RECEIVED BY
 Morrow County Surveyor

Date 11/9/81
 Rec'd By ADL
 No. 0-904 T-9

Form R6-7100-57 (9/71)