


# RECORD OF LAND CORNER MONUMENTATION

NORTH 1/4 CORNER SECTION 1, T. 6 S., R. 28 E., W.M.

ORIGINALLY ESTABLISHED BY: CORNER NOT PREVIOUSLY ESTABLISHED

CONTRACT NUMBER: N/A

CONTRACT DATE: N/A

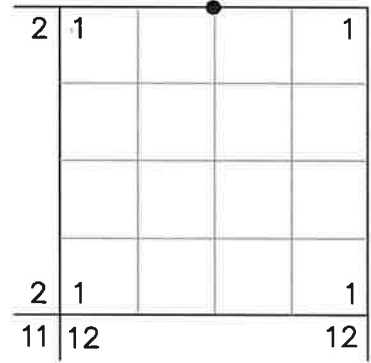

ORIGINAL DESCRIPTION: N/A

EVIDENCE FOUND: N/A


**DESCRIPTION OF MONUMENTS AND ACCESSORIES SET AND METHODS USED:**

At the corner point as determined by survey, I set a 5/8"x36" iron pin 30" in the ground, with attached 2 1/2" aluminum cap marked as shown. Surrounded monument with a 2 ft. diameter collar of stone.

**From which, I SET NEW REFERENCE POINTS:**

- ▶ A 5/8"x36" iron pin bears N.27°50'E., 15.26 ft., with attached 2 1/2" aluminum cap marked *RP 1 2021 PLS 69454*, set along an east-west running wire fence
- ▶ A 5/8"x36" iron pin bears N.34°53'W., 16.57 ft., with attached 2 1/2" aluminum cap marked *RP 2 2021 PLS 69454*, set along an east-west running wire fence

**CORNER MONUMENT MARKED:**

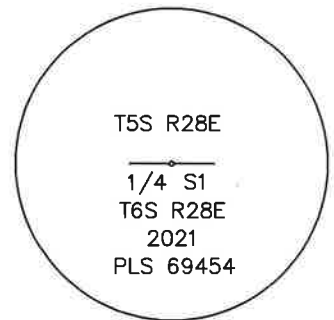

**Also from which, I SCRIBE NEW BEARING TREES:**

- ▶ A Douglas fir 14" dbh bears S.02°46'W., 59.36 ft. marked *1/4S1* in upper blaze and *BT* in lower blaze
- ▶ A western larch 14" dbh bears S.45°12'W., 35.76 ft. marked *1/4S1* in upper blaze and *BT* in lower blaze

Painted a 6 inch red band around each bearing tree, and also painted the blazes red. Attached USFS 54-3 and 54-9 signs to the bearing trees.

Bearings and distances to accessories were measured with a total station. Distances to trees were measured to a 60d nail driven in the right-side-center at the root crown of each tree, with an attached 1 1/2" brass washer stamped *PLS 69454*. Bearings are geodetic, derived by GPS observation at the corner.

**RESTORATION BY, STAMP AND DATE:**

Work Performed July 29, 2021 by:

Jason L. Hatfield, PLS  
 Vincent L. Kelly, Survey Tech  
 Daniel B. Lee

USDA FOREST SERVICE  
 NORTHEAST OREGON LAND ZONE  
 1550 Dewey Avenue, Suite A  
 Baker City, OR 97814  
 (541) 523-1337



EXPIRES: 6/30/2023

9/27/21

By: MPK

No: 6528 A23

SURVEY: 2021-1956D