


RECORD OF LAND CORNER MONUMENTATION

EAST 1/4 CORNER SECTION 1, T. 6 S., R. 28 E., W.M.

ORIGINALLY ESTABLISHED BY: Edward W. Sanderson, U.S. Deputy Surveyor

CONTRACT NUMBER: 368

CONTRACT DATE: September 7, 1880

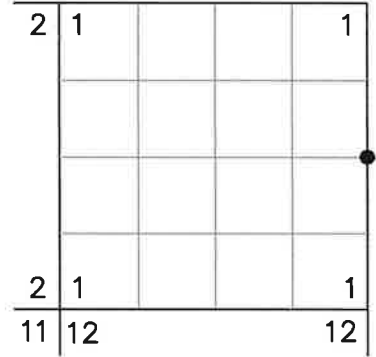

ORIGINAL DESCRIPTION: A fir 6 in dia for 1/4 sec cor. from which a pine 8 in dia. S.30°E. 21 lks.

EVIDENCE FOUND: After a diligent search, I found no remaining evidence of the original corner. The search area shows signs of extensive disturbance from logging activity. I determined this corner lost, and reestablish it by single proportionate measurement between the found accepted monuments at the northeast corner and the southeast corner of Section 1.

DESCRIPTION OF MONUMENTS AND ACCESSORIES SET AND METHODS USED:

At the corner point as determined by survey, I set a standard USFS 2½"x30" aluminum pipe with attached ¾" aluminum cap, 29" in the ground. Cap is marked as shown below.


From which, I SET NEW REFERENCE MONUMENTS:

- ▶ A 5/8"x24" iron pin bears N.38°07'E., 13.86 ft., with attached 2½" aluminum cap marked *RM 1 2021 PLS 69454*
- ▶ A 5/8"x24" iron pin bears S.41°54'E., 16.40 ft., with attached 2½" aluminum cap marked *RM 2 2021 PLS 69454*

Also from which, I SCRIBE NEW BEARING TREES:

- ▶ A lodgepole pine 8" dbh bears S.39°W., 31.7 ft. marked *X* in upper blaze and *BT* in lower blaze
- ▶ A ponderosa pine 9" dbh bears N.46°W., 27.7 ft. marked *1/4S1* in upper blaze and *BT* in lower blaze

CORNER MONUMENT MARKED:

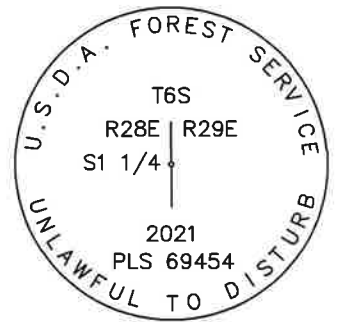

Placed a plastic-encased magnet at the base of the pipe. Painted a 6 inch red band around each bearing tree, and also painted the blazes red. Attached USFS 54-3 and 54-9 signs to the bearing trees. Distances to trees measured with an EDM, measuring to a 60d nail driven in the right-side-center at the root crown of the tree, with an attached 1½" brass washer stamped *PLS 69454*. Bearings to trees measured with a magnetic compass with 14° East declination. Used RTK GPS to measure the reference points. Bearings are geodetic, derived by GPS observation at the corner.

RESTORATION BY, STAMP AND DATE:

Work Performed August 5, 2021 by:

Robert C. Moyers, PLS
Toribio D. Quinones, LSIT
Reid B. Kelly

USDA FOREST SERVICE
NORTHEAST OREGON LAND ZONE
1550 Dewey Avenue, Suite A
Baker City, OR 97814
(541) 523-1337



EXPIRES: 6/30/2023

9/27/21 BY: MPK NO: 6528C25 SURVEY: 2021-1956D