


RECORD OF LAND CORNER MONUMENTATION

SOUTHWEST CORNER SECTION 1, T. 6 S., R. 28 E., W.M.

ORIGINALLY ESTABLISHED BY: Edward W. Sanderson, U.S. Deputy Surveyor

CONTRACT NUMBER: 368

CONTRACT DATE: September 7, 1880

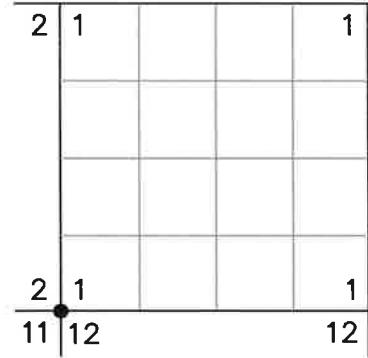

ORIGINAL DESCRIPTION: Set stone 15x12x8 in stone mound for cor. to sections 1-2-11 & 12 from which
 A tamarack 10 in. dia. bears N.10°W. 48 lks.
 A tamarack 8 in. dia. bears S.60°E. 45 lks.

EVIDENCE FOUND: Found stone 14"x11"x5" marked with 5 grooves on one face, 1 groove on opposite face, and 3 grooves on adjacent face, lying loose on downhill side of embedded mound of stone. Also found down (uprooted) rotten remains of original NW bearing tree, which bears North, 32 feet. Also found 18" dbh tamarack with K-tag set by Dennis Gaylord, PLS, which witnesses the corner. I accept the position of the mound of stone for the section corner.


DESCRIPTION OF MONUMENTS AND ACCESSORIES SET AND METHODS USED:

At the center of the found mound of stone, I set a standard USFS 2½"x30" aluminum pipe with attached ¾" aluminum cap, 28" in the ground. Raised a 3 ft. diameter mound of stone around the monument to base of cap. Cap is marked as shown below.

From which, I SCRIBE NEW BEARING TREES:

- ▶ A western larch 7" dbh bears N.63°E., 21.22 ft. marked *S1* in upper blaze and *BT* in lower blaze
- ▶ A lodgepole pine 7" dbh bears S.57°E., 16.72 ft. marked *S12* in upper blaze and *BT* in lower blaze
- ▶ A western larch 18" dbh bears S.40°W., 12.18 ft. marked *T6SR28ES11* in upper blaze and *BT* in lower blaze (with K-tag set by Gaylord attached)
- ▶ A Douglas fir 5" dbh bears N.37°W., 15.85 ft. marked *S2* in upper blaze and *BT* in lower blaze

CORNER MONUMENT MARKED:

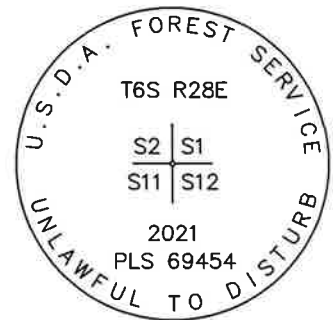

Deposited original stone southeast and alongside pipe. Placed a plastic-encased magnet at the base of the pipe. Painted a 6 inch red band around each bearing tree, and also painted the blazes red. Attached USFS 54-3 and 54-9 signs to the bearing trees.

Distances to trees measured with a steel tape, measuring to a 60d nail driven in the right-side-center at the root crown of each tree, with an attached 1½" brass washer stamped *PLS 69454*. Bearings to trees measured with a magnetic compass with 14° East declination.

RESTORATION BY, STAMP AND DATE:

Work Performed June 15, 2021 by:

Jason L. Hatfield, PLS
 Daniel B. Lee

USDA FOREST SERVICE
 NORTHEAST OREGON LAND ZONE
 1550 Dewey Avenue, Suite A
 Baker City, OR 97814
 (541) 523-1337



EXPIRES: 6/30/2023

9/27/21

By: MPK

NO: 6S28E21

SURVEY: 2021-1956D