


CERTIFIED RECORD OF LAND CORNER MONUMENTATION

E-23

History of original corner establishment: This corner was originally established on May 19, 1881, by Edward W. Sanderson under G.L.O. Contract Number 368, as follows:

Marked a tamarack 10" in diameter for quarter section corner from which:

A fir, 12" in diameter bears East, 14 lks (9.2 ft.).

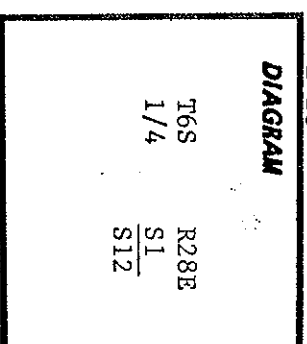

Description of corner evidence found: I found the original corner tree, now a 14" western larch snag with a healed blaze on the North side. I opened this blaze and found reverse scribing, "1/4S".

A root hole is all that remains at the position of the original bearing tree.

Description of monument and accessories | established to perpetuate the original location of this corner: I established the following accessories:

A 2 1/2" x 30" iron pipe with a 3" brass cap attached bears N89°35'27"E, 2.8 ft. Iron pipe is set 25" into the ground and is marked:

From the corner tree:

A 17" white fir bears N31°W, 21.5 ft., scribed "1/4 S1 BT" on a single blaze.

T6S	R28E
1/4	S1
	S12

A 22" Douglas-fir bears S74°E, 25.4 ft., scribed "1/4 S12 BT" on a single blaze.

N. C.
←
2.8'
PLS 1636
1984


Both new bearing trees have a 3/4" brass washer, marked "PLS 1636" nailed flush between the scribed "B" and "T", and have 54-3 and 54-4 signs attached. The corner tree has a 54-4 and a 54-5 sign attached. A 6' steel fence post with a 54-4 sign attached is set 6' East of the corner tree.

Compass Declination: 20° East

I hereby certify the above corner location was perpetuated as hereon described on June 26, 1984.

Witnesses: Susan Newstetter
Cathy McGuire

Office of..... County Surveyor..... County of..... Morrow
State of..... Oregon..... I hereby certify that the within instrument was filed in this office
for record on the..... day of....., 19.....

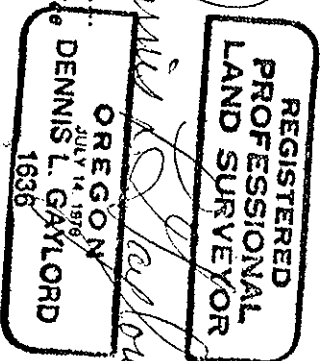
Dennis L. Gaylord

..... by..... (COUNTY OFFICIAL) (DEPUTY)

Form R6-7100-57 (9/71)

RECEIVED BY
Morrow County Surveyor
Date: 8/8/84
Filed by M.L.D.
No. 618-K