


**CERTIFIED RECORD OF LAND CORNER MONUMENTATION**

E-24

History of original corner establishment:

None

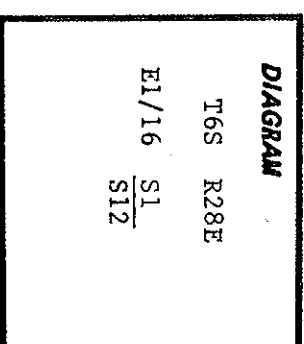

Description of corner evidence found:  
None

Description of monument and accessories I established to perpetuate the original location of this corner: A dwelling has been constructed over the corner, thus I am unable to monument or occupy the corner position.

At a point S89°35'27"W, 7.00 feet from the corner position, I set a 2½" x 30" iron pipe, with a 3" brass cap attached, 25" into the ground. Brass cap is marked:  
I built a mound of stones around the pipe.

From the corner position:

T6S	R28E
E1/16	S1
	S12
W.C. →	
7.0'	

A 11" Douglas-fir bears S75°0'W, 24.4 ft., scribed "E1/16 S12 BT" on a single blaze.

A 17" Douglas-fir bears N73°0'40"W, 66.8 ft., scribed "E1/16 S1 BT" on a single blaze. PLS 1636 1984

An unrecorded 1½" iron pipe protruding 1" above ground bears N77°33'56"W, 15.79 feet from the corner position.


Corner and accessory positions determined with a Theodolite and E.D.M.

Both bearing trees have a 3/4" brass washer, marked "PLS 1636", nailed flush between the scribed "B" and "T", and 54-3 and 54-9 signs attached. A 6' steel fence post with a 54-9 sign attached is set 1 foot North of the brass capped witness corner.

I hereby certify the above corner location was established and referenced as hereon described on July 10, 1984.

Witness: Cathy McGuire

Office of...County Surveyor.....County of...Morrow  
State of...Oregon..... I hereby certify that the within instrument was filed in this office on July 14, 1984 for record on the..... day of....., 19.....  
..... by ..... (DEPUTY)

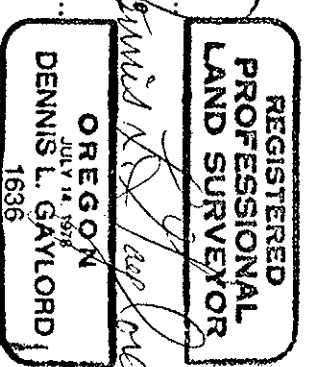

Form R6-7100-57 (9/71)

Recorded by MLD  
Date 8/8/84  
No. 692-K