

CERTIFIED RECORD OF LAND CORNER MONUMENTATION


T6S, R28E

E-25

**History of original corner establishment:** This corner was originally established on May 13, 1881, by Edward W. Sanderson under G.L.O. Contract Number 368, as follows:

Set stone 15" x 8" x 8" in stone mound for corner to Sections 1, 12, 6 and 7, from which:

- A pine 30" in diameter bears S30°E, 48 lks (31.7 ft.)
- A pine 30" in diameter bears S45°W, 68 lks (44.9 ft.)
- A tamarack 10" in diameter bears N28°W, 50 lks (33.0 ft.)

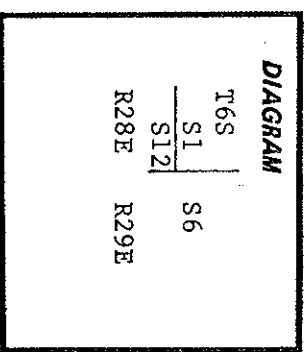

On June 24, 1881, under G.L.O. Contract Number 380, Henry Meldrum established the closing corner for Sections 6 and 7, T.6S., R.29E., 9.60 chains south of this corner, making this a section corner common to Sections 1 and 12 only.

**Description of corner evidence found:** I found the original corner stone set solidly in a mound of stones and marked with one groove on the North face, six grooves on the West face and five grooves on the South face. Stone measures 14" x 10" x 8".

I found the following original bearing trees:

- A 36" x 6' high broken ponderosa pine stump bears S28½°E, 31.3 feet. Scribes, "T6S R29E", are visible on upper blaze. Lower blaze is healed.
- A 34" sawn ponderosa pine stump bears S43°W, 44.9 feet. A portion of the lower healed blaze remains. It is detached and lying alongside the stump.
- A 10" western larch is down and out of position, disturbed by logging activities. Scribes are visible on an unhealed blaze which is lying face down. I am unable to determine the original standing position of this tree.

**Description of monument and accessories established to perpetuate the original location of this corner:** Moving the corner stone aside, I set in it's place a 2½" x 30" iron pipe with a 3" brass cap attached. Brass cap is protruding 4". I built a small mound of stones around the pipe. The brass cap is marked:

- From which:
 

T6S	T6S
S1	R29E
S12	S6
- A 20" ponderosa pine bears N85°W, 33.6 feet, scribed "T6S R28E S1 BT" on a single blaze.
 

R28E	
PLS	1636
	1984
- A 18" Douglas-fir bears S57°W, 36.7 feet, scribed "T6S R28E S12 BT" on a single blaze.

Both new bearing trees have a 3/4" brass washer, marked "PLS 1636", nailed flush between the scribed "B" and "T", and 54-3 and 54-4 signs attached. A 6' steel fence post with a 54-4 sign attached is set 6' North of corner.

Compass Declination: 20° East

I hereby certify the above corner location was perpetuated as hereon described on June 26, 1984.

Witnesses: Susan Newstetter  
Cathy McGuire

RECEIVED BY  
Morrow County Surveyor

Date 8/8/84  
Rec'd by MLD  
No. 074-K

*Dennis L. Gaylord*

**REGISTERED  
PROFESSIONAL  
LAND SURVEYOR**

OREGON  
JULY 1975  
**DENNIS L. GAYLORD**  
1636

Office of.....County Surveyor.....Morrow  
State of.....Oregon..... I hereby certify that the within instrument was filed in this office  
for record on the..... day of....., 19.....  
..... by ..... (DEPUTY)  
(COUNTY OFFICIAL)