


RECORD OF LAND CORNER MONUMENTATION

SOUTH 1/4 CORNER SECTION 11, T. 6 S., R. 28 E., W.M.

ORIGINALLY ESTABLISHED BY: Edward W. Sanderson, U.S. Deputy Surveyor

CONTRACT NUMBER: 368

CONTRACT DATE: September 7, 1880

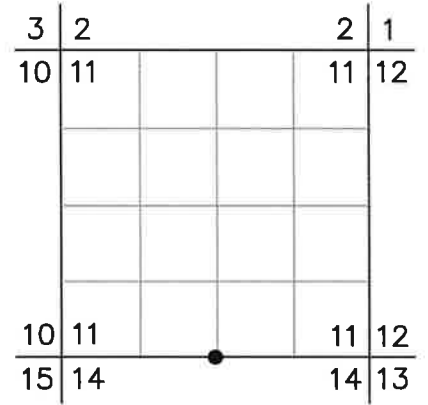

ORIGINAL DESCRIPTION: Marked a juniper 15 in dia for qur. sec. cor. from which
A Pine 24 in dia. bears S.50°E. 50lks

EVIDENCE FOUND: Found double-trunk juniper, the northerly trunk is 11" dbh with blaze and illegible scribing on the north side of tree. Also found original BT, which is a ponderosa pine snag, 28" dbh with scribed 1/4 visible in upper blaze and scribed BT visible in lower blaze, bears S.50°E., 31.7 feet. I accept the position of the found juniper tree for the 1/4 corner.

DESCRIPTION OF MONUMENTS AND ACCESSORIES SET AND METHODS USED:

I leave the juniper corner tree in place, and attached a USFS 54-9 sign and a K-Tag with a brass washer stamped PLS 69454. Also painted a 6 inch red band around the tree and the letters CT.

From which, I SET NEW REFERENCE POINTS:

- ▶ A 5/8"x12" iron pin driven 8" into a drill hole in bedrock, bears N.44°17'E., 32.23 ft., with attached 2" aluminum cap marked RP 1 2021 PLS 69454
- ▶ A 5/8"x12" iron pin driven 8" into a drill hole in bedrock, bears S.62°04'E., 43.45 ft., with attached 2" aluminum cap marked RP 2 2021 PLS 69454
- ▶ A 5/8"x12" iron pin driven 8" into a drill hole in bedrock, bears S.67°53'W., 51.80 ft., with attached 2" aluminum cap marked RP 3 2021 PLS 69454
- ▶ A 5/8"x8" iron pin driven 6" into a drill hole in bedrock, bears N.50°11'W., 34.12 ft., with attached 2" aluminum cap marked RP 4 2021 PLS 69454. The top of the aluminum cap is 2" below ground level

Painted a 6 inch red band around the found bearing tree, and painted the blaze red. Also attached USFS 54-9 sign to the found bearing tree. Used a magnetic compass with 14° East declination and a steel tape to measure the BT, measuring to the center of the tree. Used RTK GPS to measure the reference points. Bearings are geodetic, derived by GPS observation at the corner.

RESTORATION BY, STAMP AND DATE:

Work Performed August 10, 2021 by:

Jason L. Hatfield, PLS
Vincent L. Kelly, Survey Tech
Daniel B. Lee

USDA FOREST SERVICE
NORTHEAST OREGON LAND ZONE
1550 Dewey Avenue, Suite A
Baker City, OR 97814
(541) 523-1337



EXPIRES: 6/30/2023

9/27/21

BY: MPK

NO: 6528 J19

SURVEY: 2021-1956D