


RECORD OF LAND CORNER MONUMENTATION

SOUTHWEST CORNER SECTION 12, T. 6 S., R. 28 E., W.M.

ORIGINALLY ESTABLISHED BY: Edward W. Sanderson, U.S. Deputy Surveyor

CONTRACT NUMBER: 368

CONTRACT DATE: September 7, 1880

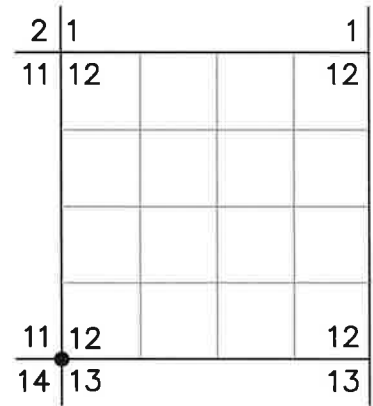

ORIGINAL DESCRIPTION: Set a stake for cor. to sections 11-12-13 & 14 from which
 A black pine 8 in dia. bears N.40°E., 42 lks. dist.
 A black pine 8 in dia. bears S.22°E. 12 lks. dist.
 A black pine 9 in dia. bears N.85°W. 46 lks. dist.
 A black pine 6 in dia. bears S.46°W. 23 lks. dist.

EVIDENCE FOUND: After a diligent search, I found no remaining evidence of the original corner. The search area shows signs of extensive disturbance from logging activity. I determined this corner lost, and reestablish it by double proportionate measurement between the found accepted monuments at the northwest corner of Section 12, the West 1/4 Corner of Section 13, the South 1/4 Corner of Section 11, and the southeast corner of Section 12.

DESCRIPTION OF MONUMENTS AND ACCESSORIES SET AND METHODS USED:

At the corner point as determined by survey, I set a standard USFS 2½"x30" aluminum pipe with attached 3¼" aluminum cap, 25" in the ground. Raised a 2 ft. diameter mound of stone around monument to base of cap. Cap is marked as shown below.


From which, I SET A NEW REFERENCE MONUMENT:

- ▶ A 5/8"x30" iron pin bears N.64°26'W., 13.40 ft., with attached 2½" aluminum cap marked *RM 2021 PLS 69454*

Also from which, I SCRIBE NEW BEARING TREES:

- ▶ A lodgepole pine 7" dbh bears N.12°E., 9.3 ft. marked *X* in upper blaze and *BT* in lower blaze
- ▶ A lodgepole pine 9" dbh bears N.85°E., 35.95 ft. marked *T6SR28ES12* in upper blaze and *BT* in lower blaze
- ▶ A western larch 19" dbh bears S.44°W., 56.8 ft. marked *T6SR28ES14* in upper blaze and *BT* in lower blaze

CORNER MONUMENT MARKED:

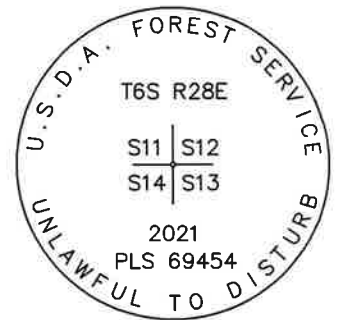

Placed a plastic-encased magnet at the base of the pipe. Painted a 6 inch red band around each bearing tree, and also painted the blazes red. Attached USFS 54-3 and 54-9 signs to the bearing trees. Distances to trees measured with a steel tape, measuring to a 60d nail driven in the right-side-center at the root crown of the tree, with an attached 1½" brass washer stamped *PLS 69454*. Bearings to trees measured with a magnetic compass with 14° East declination. Used RTK GPS to measure the reference points. Bearings are geodetic, derived by GPS observation at the corner.

RESTORATION BY, STAMP AND DATE:

Work Performed July 28, 2021 by:

Robert C. Moyers, PLS
 Toribio D. Quinones, LSIT
 Reid B. Kelly

USDA FOREST SERVICE
 NORTHEAST OREGON LAND ZONE
 1550 Dewey Avenue, Suite A
 Baker City, OR 97814
 (541) 523-1337



Jason L. Hatfield



EXPIRES: 6/30/2023

9/27/21

BY: MPK

NO: 6S28J21

SURVEY: 2021-1956D