


RECORD OF LAND CORNER MONUMENTATION

SOUTHEAST CORNER SECTION 12, T. 6 S., R. 28 E., W.M.

ORIGINALLY ESTABLISHED BY: Edward W. Sanderson, U.S. Deputy Surveyor

CONTRACT NUMBER: 368

CONTRACT DATE: September 7, 1880

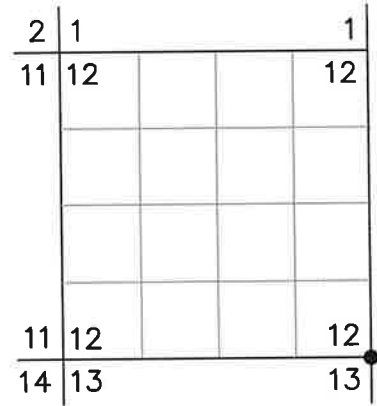

ORIGINAL DESCRIPTION: Set stone 14x8x8 in stone mound for cor to sec's. 12, 13, 7, 18 from which
 A Pine 24 in dia N10°E 47lks
 A Pine 28 in dia S73°W 108lks

EVIDENCE FOUND: Search area has been disturbed by logging and/or fire suppression activities. Found stone 14"x10"x9" lying loose on the ground with no other stones. When set upright and oriented, stone is marked with 4 grooves on south face and 6 grooves on west face. Also found original SW bearing tree, which is a wind-thrown ponderosa pine, 28" dbh, with open double blazes and K-tag set by Dennis Gaylord, PLS in 1984. No scribing was visible due to the blazes being charred by fire. Also found a possible mound of stone 5 ft.+/- Easterly of the marked stone. I do not accept the position of the found stone or the mound of stone, as there has clearly been substantial disturbance in the area, and neither position related well to the found bearing tree. Therefore, I reestablish the corner at G.L.O. record bearing and distance from the center of the rootwad hole of the found BT, which is the best available evidence of the original corner.

DESCRIPTION OF MONUMENTS AND ACCESSORIES SET AND METHODS USED:

At the corner point, I set a standard USFS 2½"x30" aluminum pipe with attached ¾" aluminum cap, 24" in the ground. Raised a 3 ft. diameter mound of stone around monument to base of cap. Cap is marked as shown below.

From which, I SET NEW REFERENCE POINTS:

- ▶ A 5/8"x18" iron pin driven to bedrock bears N.38°43'E., 25.53 ft., with attached 2½" aluminum cap marked *RP 1 2021 PLS 69454*
- ▶ A 5/8"x36" iron pin bears S.45°15'E., 28.34 ft., with attached 2½" aluminum cap marked *RP 2 2021 PLS 69454*

Also from which, I SCRIBE NEW BEARING TREES:

- ▶ A ponderosa pine 8" dbh bears S.38°22'W., 72.0 ft. marked *X* in upper blaze and *BT* in lower blaze
- ▶ A ponderosa pine 10.5" dbh bears N.56°07'W., 32.5 ft. marked *T6SR28ES12* in upper blaze and *BT* in lower blaze

CORNER MONUMENT MARKED:



Also from which, the center of the rootwad hole of the original BT bears S.73°00'W., 71.3 ft.

Deposited original stone right side up, southeast and alongside pipe. Placed a plastic-encased magnet at the base of the pipe. Painted a 6 inch red band around each bearing tree, and also painted the blazes red. Attached USFS 54-3 and 54-9 signs to the bearing trees.

Distances to trees measured with a steel tape, measuring to a 60d nail driven in the right-side-center at the root crown of each tree, with an attached 1½" brass washer stamped *PLS 69454*. Used RTK GPS to measure the reference points, and to measure bearings to BT's. Bearings are geodetic, derived by GPS observation at the corner.

RESTORATION BY, STAMP AND DATE:


Work Performed July 28, 2021 by:

Jason L. Hatfield, PLS
 Vincent L. Kelly, Survey Tech
 Daniel B. Lee

USDA FOREST SERVICE
 NORTHEAST OREGON LAND ZONE
 1550 Dewey Avenue, Suite A
 Baker City, OR 97814
 (541) 523-1337



Jason L. Hatfield

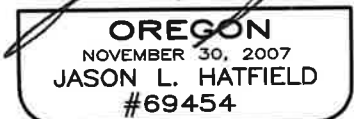

EXPIRES: 6/30/2023

9/27/21

BY: MAK

NO: 6528J2S

SURVEY: 2021-1956D