


RECORD OF LAND CORNER MONUMENTATION

WEST 1/4 CORNER SECTION 13, T. 6 S., R. 28 E., W.M.

ORIGINALLY ESTABLISHED BY: Edward W. Sanderson, U.S. Deputy Surveyor

CONTRACT NUMBER: 368

CONTRACT DATE: September 7, 1880

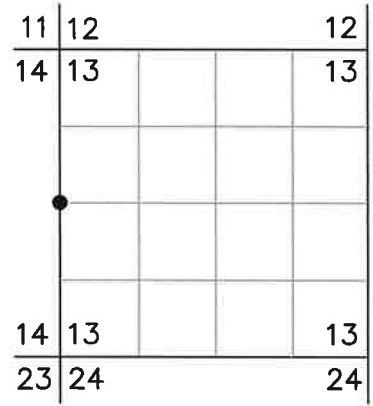

ORIGINAL DESCRIPTION: Set stone 14x14x4 in stone mound for qur. sec. cor. from which A pine 24 in dia. bears North, 30 lks. dist.

EVIDENCE FOUND: Found stone 15"x13"x3" marked 1/4 tipped over in a mound of stone. Also found the original BT, which is a ponderosa pine snag 30 ft. tall, bears N.10°W., 19.3 ft., with healed double blaze and "X" chopped into east and west sides about 5 feet up the tree. I accept the position of the found stone for the 1/4 corner.

DESCRIPTION OF MONUMENTS AND ACCESSORIES SET AND METHODS USED:

At the position of the found stone, I set a standard USFS 2 1/2"x30" aluminum pipe with attached 3 1/4" aluminum cap, 28" in the ground. Raised a 3 ft. diameter mound of stone around monument to base of cap. Cap is marked as shown below.


From which, I SET A NEW REFERENCE POINT:

- ▶ A 5/8"x30" iron pin bears S.29°33'W., 47.40 ft., with attached 2 1/2" aluminum cap marked *RP 1 2021 PLS 69454*

Also from which, I SCRIBE NEW BEARING TREES:

- ▶ A Douglas fir 19" dbh bears N.32°E., 66.3 ft. marked 1/4S13 in upper blaze and BT in lower blaze
- ▶ A ponderosa pine 9.5" dbh bears S.62°E., 44.10 ft. marked X in upper blaze and BT in lower blaze
- ▶ A ponderosa pine 17" dbh bears N.68°W., 40.50 ft. marked 1/4S14 in upper blaze and BT in lower blaze

CORNER MONUMENT
MARKED:

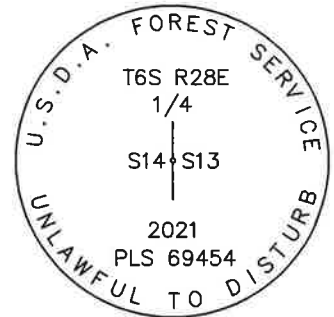

Painted a 6 inch red band around each bearing tree, and also painted the blazes red. Attached USFS 54-3 and 54-9 signs to the bearing trees.

Distances to trees measured with a steel tape, measuring to a 60d nail driven in the right-side-center at the root crown of each tree, with an attached 1 1/2" brass washer stamped *PLS 69454*. Bearings to trees measured with a magnetic compass with 14° East declination. Used RTK GPS to measure the reference point, with geodetic bearing derived by GPS observation at the corner.

RESTORATION BY, STAMP AND DATE:

Work Performed June 15, 2021 by:

Jason L. Hatfield, PLS
Daniel B. Lee

USDA FOREST SERVICE
NORTHEAST OREGON LAND ZONE
1550 Dewey Avenue, Suite A
Baker City, OR 97814
(541) 523-1337



EXPIRES: 6/30/2023

9/27/21

BY: MPK

NO: 6528L21

SURVEY: 2021-1956D