


CERTIFIED RECORD OF LAND CORNER MONUMENTATION

R-25

History of original corner establishment:

Corner established in 1881 by Meldrum and Campbell under General Land Office Contract No. 380. Surveyor General Records states: Set a basalt stone 22" X 20" X 6" in mound of stone for cor. to sections 19, 24, 25, 30.

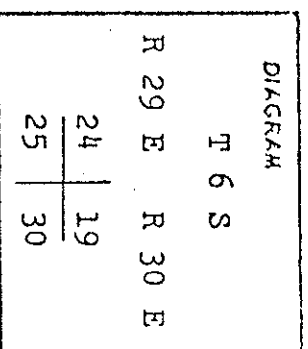

No record of subsequent remonumentation was found in county records.

Description of corner evidence found:


None

( See map of Survey, dated December, 1975 )

Description of monument and accessories established to perpetuate the original location of this corner

At proportionate distance I set 2 1/2" X 30" iron pipe with brass cap marked as shown 14" in ground from which:

- A 24" Juniper bears N 27° E, 124.8 ft. marked  
T6S R30E S19 BT.
  - A 11" Pine bears S 14° E, 106.4 ft. marked  
T6S R30E S30 BT.
  - A 12" Juniper bears S 76° W, 73.3 ft. marked  
T6S R29E S25 BT.
  - A 13" Juniper bears N 45° W, 94.7 ft. marked  
T6S R29E S24 BT.
- Raised mound of stone 5 ft. base to top of cap.  
Set steel fence post 5+ ft. South.

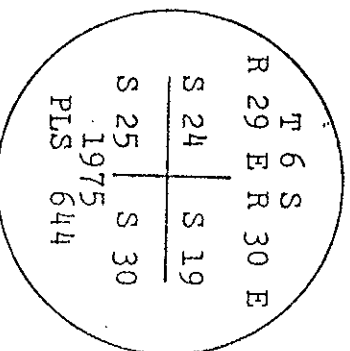

REGISTERED  
PROFESSIONAL  
LAND SURVEYOR

OREGON  
JULY 10, 1964  
DUANE I. GRIFFITH  
644

Brass Washer nailed to BT blazes.  
Used steel tape and magnetic compass with 19° 30' East declination.  
Measured to center of all BTs.

Office of ..... County of .....  
 State of ..... , I hereby certify that the within instrument was filed in this office  
 for record on the ..... day of .....  
 (COUNTY OFFICIAL) ..... by ..... (DEPUTY)

# 3/3-K

# 3/3-K