


CERTIFIED RECORD OF LAND CORNER MONUMENTATION

V-13

History of original corner establishment:

Corner originally established by Henry Meldrum, U.S. Deputy Surveyor, under GLO Contract No. 380 dated March 19, 1881. Surveyor General records state:

Set a basalt stone 15 x 12 x 6 in a mound of stone for cor. to secs. 27, 28, 33, 34.

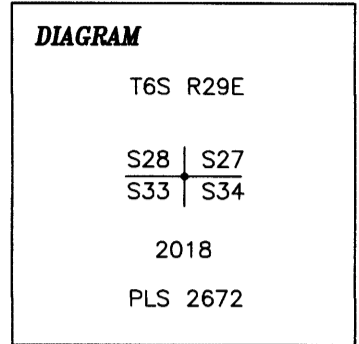

U.S. Forest Service Cap

Corner searched for by U.S. Forest Service Surveyor, Dennis L. Gaylord, PLS 1636, on May 26, 1995. Gaylord's record states:

Nothing found, search area is just East of a dam in draw. Area disturbed during dam construction.

Description of corner evidence found:

Nothing found after multiple search attempts.

Description of monument and accessories I established to perpetuate the original location of this corner:

At position determined by survey, set a 2½" X 30" aluminum pipe with ¾" aluminum cap marked as shown in Corner Diagram set 24" above ground with magnet drilled into bedrock underneath. Construct mound of stone 5' in diameter around corner monument. From which:


- A Juniper 18" in diameter bears N33°E, 39.6' scribed X BT.
- A Juniper 20" in diameter bears S77°E, 31.8' scribed T6SR29ES34 BT.
- A 5/8" X 30" rebar with 2" aluminum cap 6" above ground bears S33°W, 12.5'.
- A stone in place 32" X 26" X 10" bears N15°W, 29.5' marked B_XO with MagNail at center of X.

Set aluminum fence posts 5" East and West of corner with 54-9 sign and 54-2 signs.

Distance to bearing trees measured to MagNail in right side center. Bearing trees have brass disk stamped PLS 2672 nailed between the B and T on lower face. Bearing trees have 54-3 and 54-9 signs, a 6" red painted band, and bearing tree face painted red. Distance to BO measured to center of MagNail. Bearings measured with hand compass, distances measured with steel tape.

Cap on rebar oriented to North and marked as shown in drawing below.

Geodetic Coordinates (NAD83)
N 45°00'36.8"
W 119°13'26.7"

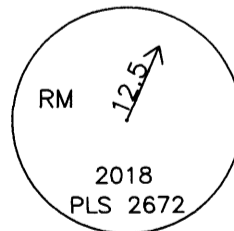

Geodetic coordinates were obtained from a Garmin recreational grade GPS receiver.

Date: June 5, 2018
Declination: 14° E
Witnesses: Robert Moyers, Dan Lee, Doug Crawford, Danny O'Neal, Ray Denig, Kathryn Daugherty.

RECEIVED BY

Morrow County Surveyor

Date: 8-10-2018
Rec'd By: S.K.H.
No.: 6529V13
Folder No.: _____

**REGISTERED
PROFESSIONAL
LAND SURVEYOR**

OREGON
JULY 19, 1994
KENNETH A. LIND
2672

Renews: 12-31-18