


CERTIFIED RECORD OF LAND CORNER MONUMENTATION

X-13

History of original corner establishment:

Corner originally established by Henry Meldrum, U.S. Deputy Surveyor, under GLO Contract No. 380 dated March 19, 1881. Surveyor General records state:

Set a basalt stone 14 x 12 x 5 in a mound of stone for 1/4 sec. cor.

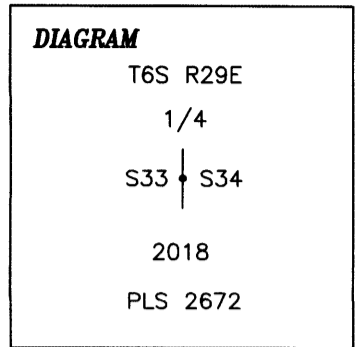

U.S. Forest Service Cap

Corner stone recovered by U.S. Forest Service Surveyor, Dennis L. Gaylord, PLS 1636, on August 19, 1997. Gaylord's record states:

Found stone a bit smaller than record size set in a mound of stones. Possible marks on one face. I placed 8 dead batteries under the corner stone as a memorial.

Description of corner evidence found:

Found original stone 13" X 11" X 5" marked 1/ with possible 4 in a mound of stone with batteries underneath.

Description of monument and accessories I established to perpetuate the original location of this corner:

Replace original stone with 2 1/2" X 30" aluminum pipe with 3/4" aluminum cap marked as shown in Corner Diagram set 12" above ground with clear magnet at base. Inverted original stone and placed North of corner monument in 4' diameter mound of stone. Set aluminum fencepost with 54-9 sign 15' Southwesterly. From which:

- A Juniper 24" in diameter bears N88°E, 18.0' scribed X BT.
- A Juniper 16" in diameter bears S21°W, 33.2' scribed 1/4 S33 BT.
- A Juniper 16" in diameter bears S75°W, 59.8' scribed 1/4 S33 BT.
- A 5/8" X 30" rebar with red plastic cap 8" above ground stamped Umatilla N.F. bears N74°W, 18.9'.

Distances to new bearing trees measured to MagNail in right side center. New bearing trees have brass disk stamped PLS 2672 nailed between the B and T on lower face. New bearing trees have 54-3 and 54-9 signs, a 6" red painted band, and bearing tree face painted red. Bearings measured with hand compass, distances measured with steel tape.

Corner lies on Southerly slope, 30' South of a rock ledge.

Geodetic Coordinates (NAD83)

N 45°00'10.7"
W 119°13'26.8"

Geodetic coordinates were obtained from a Garmin recreational grade GPS receiver.

Date: June 6, 2018

Declination: 14° E

Witnesses: Robert Moyers, Danny O'Neal, Ray Denig, Kathryn Daugherty.

RECEIVED BY
Morrow County Surveyor

Date: 8-10-2018

Rec'd By: S.K.H.

No.: 6529X13

Folder No.: _____

REGISTERED
PROFESSIONAL
LAND SURVEYOR

OREGON
JULY 19, 1994
KENNETH A. LIND
2672

Renews: 12-31-18