

CERTIFIED RECORD OF LAND CORNER MONUMENTATION


A-11

History of original corner establishment:

This corner was established by A. York in 1879 under G.L.O. contract No. 309. He marked a Fir, 6" dia., for the $\frac{1}{4}$ corner from which:

- A Tamarrack, 20" dia., N10W, 9 links
- A Fir, 4" dia., S20⁰W, 9 links

This corner was not found by E.W. Sanderson during his 1881 retracement under G.L.O. contract No. 368.

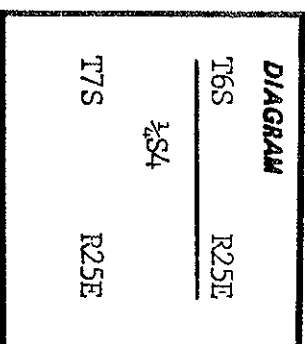

Description of corner evidence found:

I found no evidence of the original corner.


Description of monument and accessories I established to perpetuate the original location of this corner:

By proportionate measurement (See Place and Narrative of Porter Cadastral Survey) I set a 2 $\frac{1}{2}$ "x30" alum. pipe with an alum. cap containing a magnet and marked:

From which:
 Spruce, 12" dia., bears S58 3/4⁰E, 18.0 ft.
 White Fir, 9" dia., bears S37 $\frac{1}{2}$ ⁰W, 24.7 ft.

The B.T.'s have an "attention" sign, a B.T. tag, a 6" red enamel stripe and an alum. "PLS 1832" washer and are scribed according to the manual.

There is a 6' steel fence post with an "attention" sign within 5' of the corner.

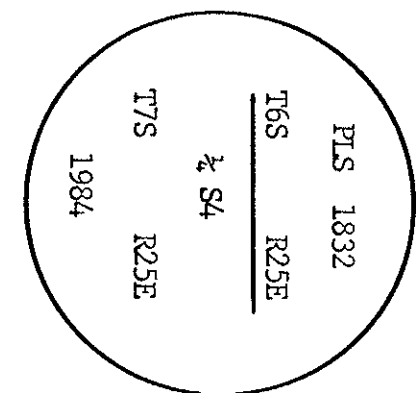

REGISTERED
 PROFESSIONAL
 LAND SURVEYOR

Fayette S. Munro

OREGON
 JULY 13, 1879
 FAYETTE S. MUNRO
 1832

RECEIVED BY

Morrow County Surveyor
 Date 10/24/84
 Rec'd by MLO
 No. 695-R

Office of.....*SURVEYOR*..... County of.....*MORROW*.....
 State of.....*OREGON*..... I hereby certify that the within instrument was filed in this office
 for record on the.....*2*..... day of.....*July*....., 19*84*
Fayette S. Munro
 (COUNTY OFFICIAL) by (DEPUTY)