


CERTIFIED RECORD OF LAND CORNER MONUMENTATION

A-13

History of original corner establishment:

This corner was established in 1879 by A. York under G.L.O. contract No. 309. He set a stone 20"x12"x8" in a stone mound for the corner to the Secs. 3,4,33 and 34.

This corner was found by E.W. Sanderson in his retracement of 1881 under G.L.O. contract No. 368. He found a stone 16"x10"x7" in a mound.

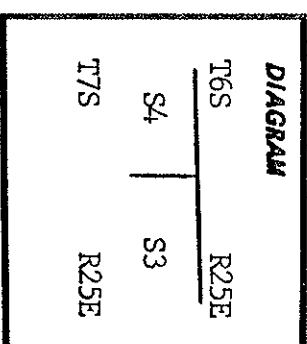

Description of corner evidence found:

I found no evidence of this corner.


Description of monument and accessories | established to perpetuate the original location of this corner:

By proportionate measurement (See Plat and Narrative of Porter Cadastral Survey), I set a 2½"x30" alum. pipe in a mound with a 3" alum. cap containing a magnet and marked:

From which:
 Douglas Fir, 30" dia., bears S63¾°W, 26.3 ft.
 White Fir, 14" dia., bears S57¾°E, 59.4 ft.

The B.T.'s have an "attention" sign, a B.T. tag, a 6" red enamel stripe and an alum. "PLS 1832" washer and are scribed according to the manual.

There is a 6' steel fence post with an "attention" sign within 5' of the corner.

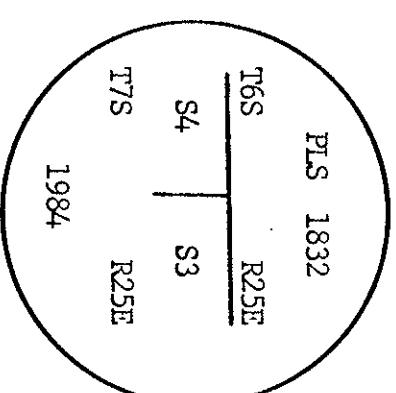

REGISTERED
 PROFESSIONAL
 LAND SURVEYOR

OREGON
 JULY 13, 1979
 FAYETTE S. MUNRO
 1832

Fayette S. Munro

Office of..... *Surveyor* County of..... *Marion*
 State of..... *Oregon* I hereby certify that the within instrument was filed in this office
 for record on the... *3rd* day of... *July* , 1984.
David H. K. [Signature] by (DEPUTY)

Marion County Surveyor
 File 10/24/84
 Recd of MLD
 No. 693-K