


History of original corner establishment:


This corner was found in 1881 by E.W. Sanderson during his re-tracement under G.I.O. contract No. 368. He found a stone 12"x6"x6" from which:

- A Fir, 8" dia., bears S55°W, 61 links
- A Cottonwood, 3" dia., bears N80°E, 44 links

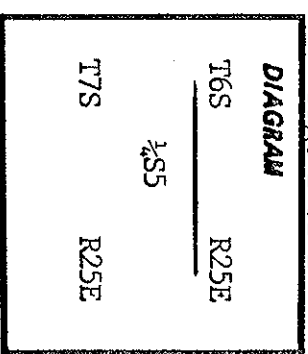

Description of corner evidence found:

Description of monument and accessories | established to perpetuate the original location of this corner:

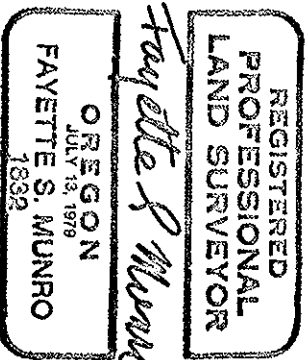

RECEIVED BY

Morrow County Surveyor
 Date 10/24/84
 Rec'd by MLD
 No. 699-K

Office of.....SURVEYOR..... County of.....MORROW.....
 State of.....OREGON..... I hereby certify that the within instrument was filed in this office
 for record on the.....2..... day of.....July....., 1984
David H. K. Lewis..... byMLD.....
 (COUNTY OFFICIAL) (DEPUTY)