


CERTIFIED RECORD OF LAND CORNER MONUMENTATION

T.7S., R.26E., INDEX A-11

History of original corner establishment:

This corner was originally established by A.F. York under G.L.O. contract No. 309, dated Nov. 18, 1878. Survey General notes state:

Set stone 15x9x6 for 1/4 sec. cor. From which
A yellow pine 30 in. in dia. bears N60°E, 12 lks dist.
A yellow pine 36 in. in dia. bears S78°W, 108 lks dist.

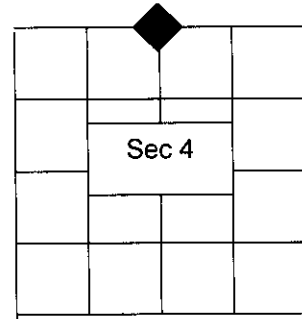

Description of corner evidence found:

No evidence of the original corner is recovered.

Description of monument and accessories I establish to perpetuate the original location of this corner:

At proportionate position, Set a 2-1/2" dia. x 30" aluminum pipe monument w/3" dia. cap stamped as shown in the DIAGRAM, 26" in the ground, raised a 2' high x 4' dia. mound of stone, from which:

- A 5/8" iron pin w/red "FS&E SURVEY MARKER" cap bears N48°33'W, 20.41 ft.
- A 5/8" iron pin w/red "FS&E SURVEY MARKER" cap bears N37°15'E, 18.08 ft.
- A 10" dia. Ponderosa Pine bears S64°43'E, 54.86 ft., scribed 1/4 S4 BT.
- A 10" dia. Ponderosa Pine bears S77°16'W, 53.91 ft., scribed 1/4 S4 BT.

DIAGRAM

T6S R26E
1/4----
S4
T7S
2008
PLS 49865


Measurements to accessories taken with Topcon Hyper II GPS and tape measure.

I hereby certify that the above corner point was perpetuated as shown hereon on October 19, 2008 and revisited on August 14, 2013.

Witness: D. Mitchell Ferguson, LSIT
David H. Herburger, Surv. Tech.

Office of Surveyor County of Morrow
State of Oregon. I hereby certify that the within instrument was filed in this office
for record on the 16th day of April, 2014

Stephen K. Haddock by _____
County Surveyor Deputy

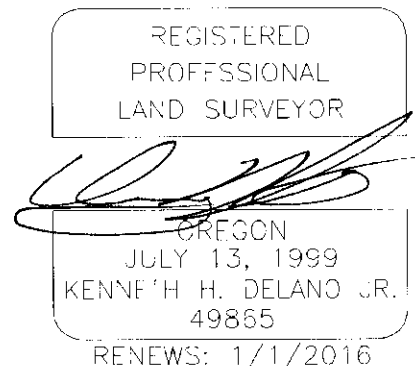

See Grant County Map of Survey No. 1985
See Morrow County Map of Survey No. 2013-1687D