


CERTIFIED RECORD OF LAND CORNER MONUMENTATION

A-15

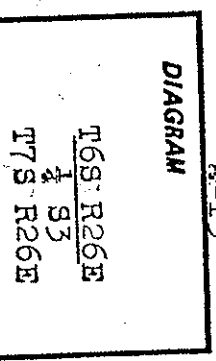

**History of original corner establishment:**

Aaron F. York, under G.L.O. contract number 309, dated Nov. 18, 1878, surveyed the north line of T.7S. R.26E. He set a stone 21"X 13"X 9" and raised a stone mound at the corner.

Edward W. Sanderson, under G.L.O. contract number 368, dated Sept. 7, 1880, retraced York's line and at this corner found a stone 12"X 12"X 5" in a stone mound.

**Description of corner evidence found:**

I found a pine stub, 11" dia., with scribing visible on a SELY facing blaze. Unrecorded BTS from York's work under contract number 309 have been reported in this township by Edward W. Sanderson, 1880 and PLS 346, 1979. PLS 1910, 1982/1983 has reported numerous unrecorded BTS in T.7S., R.24 and 25E. Originally surveyed by York under the same contract. Based on its appearance, I accept this stub as also being an original unrecorded BT marked by York.

**Description of monument and accessories established to perpetuate the original location of this corner:**

At the intersection of the line through the two original corners immediately to the west and the direction of the blaze, I set a 2 1/2"X 30" alum. pipe with a 3" alum. cap containing a magnet and marked:

T69: R26E  
1/4 S3  
T7S R26E  
PLS 1832  
1985

**From which:**

The original pine stub, 11" dia., N44 1/2°W, 17.5 ft.; marked: 1/4 S3

A Ponderosa Pine, 7" dia., S60°E, 71.7 ft.; marked: 1/4 S3 BT

A Ponderosa Pine, 6" dia., S42 1/2°W, 81.8 ft.; marked: 1/4 S3 BT

BTS have blaze and a 6" stripe painted red, an "Attention" sign and an BT tag. New BTS have, additionally, an alum. "PLS 1832" washer nailed to the bottom of the blaze. There is a 6' steel fence post with an "Attention" sign within 5' of the corner.

Measured to center of BTS using steel tape and staff compass. Magnetic declination set at 20 1/2° E.

October 11, 1985

REGISTERED PROFESSIONAL LAND SURVEYOR  <i>Fayette S. Munro</i> OREGON JULY 13, 1979 FAYETTE S. MUNRO 1832
---

Office of..... *S. W. VEYER* ..... County of..... *MARION* .....

State of..... *OREGON* ..... I hereby certify that the within instrument was filed in this office

for record on the..... *3<sup>rd</sup>*..... day of..... *DECEMBER*....., 1985

..... *W. JAMES H. KERR* ..... by ..... (DEPUTY)

(COUNTY OFFICIAL)