


CERTIFIED RECORD OF LAND CORNER MONUMENTATION

T.7S., R.26E., INDEX A-9

History of original corner establishment:

This corner was originally established by A.F. York under G.L.O. contract No. 309, dated Nov. 18, 1878. Survey General notes state:

Set stone 20x14x8 for cor. to Secs 4,5,32&33. From which
A yellow Pine, 33 in. in dia. bears N15°E, 266 lks.
A yellow Pine, 15 in. in dia. bears N45°W, 190 lks.
A yellow Pine, 34 in. in dia. bears S48°E, 503 lks.
A yellow Pine, 12 in. in dia. bears S65°W, 240 lks.

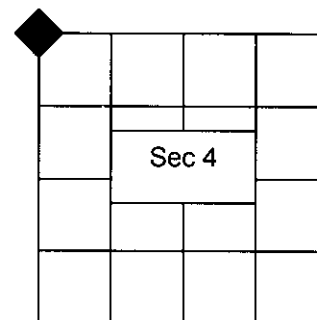

Description of corner evidence found:

No evidence of the original stone is recovered. Found 3 of the 4 record BTs and positioned the corner at best record fit from those found bearing trees as follows:

- Fd. a 28" Pine Stump with an open blaze and axe marks, bears N15°22'E, 180.92 (record N15°E, 175.56')
- Fd. a decaying 38" Pine Stump with an open blaze and axe marks, bears S37°53'E, 333.84 (record S48°E, 331.98')
- Fd. a 32" Pine Snag with an open blaze, visible scribing, bears S67°30'W, 160.25 (record S65°W, 158.40')

Description of monument and accessories I establish to perpetuate the original location of this corner:

At the position as determined from the found record bearing trees, Set a 2-1/2" dia. x 30" aluminum pipe monument w/3" dia. cap stamped as shown in the DIAGRAM, 16" in the ground, raised a 2' high x 3' dia. mound of stone, from which:

A 10" dia. Ponderosa Pine bears S22°30'W, 154.7 ft., scribed T7S R26E S5 BT.

A 5/8" iron pin w/yellow "FS&E SURVEY MARKER" cap bears S10°00'E, 33.8 ft.

DIAGRAM

T6S R26E

S5 | S4

T7S

2008

PLS 49865

Measurements to accessories taken with Topcon Hyper II GPS and tape measure.

I hereby certify that the above corner point was perpetuated as shown hereon on October 22, 2008 and revisited on August 14, 2013.

Witness: D. Mitchell Ferguson, LSIT
David H. Herburger, Surv. Tech.

Office of Surveyor County of Morrow
State of Oregon. I hereby certify that the within instrument was filed in this office
for record on the 16th day of April, 2014

Stephen K. Holdack by _____
County Surveyor Deputy

REGISTERED
PROFESSIONAL
LAND SURVEYOR

OREGON
JULY 13, 1999
KENNETH H. DELANO JR.
49865

RENEWS: 1/1/2016

See Grant County Map of Survey No. 1985
See Morrow County Map of Survey No. 2013-1687D