


CERTIFIED RECORD OF LAND CORNER MONUMENTATION

T.7S., R.26E., INDEX C-11

History of original corner establishment:

This corner was not originally established.

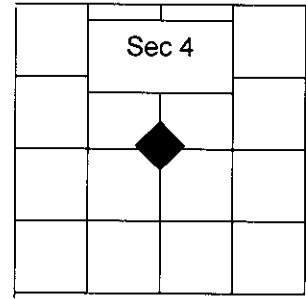

Description of corner evidence found:

Description of monument and accessories I establish to perpetuate the original location of this corner:

At the calculated position, Set a 2-1/2" dia. x 30" aluminum pipe monument w/3" dia. cap stamped as shown in the DIAGRAM, 26" in the ground, placed a 2' dia. ring of stone, from which:

- A 6" dia. Ponderosa Pine bears N53°45'W, 20.2 ft., scribed C1/4 S4 BT.
- A 10" dia. Ponderosa Pine bears N4°00'E, 8.2 ft., scribed C1/4 S4 BT.
- A 10" dia. Ponderosa Pine bears S6°15'E, 35.2 ft., scribed C1/4 S4 BT.
- A 8" dia. Ponderosa Pine bears S61°30'W, 28.7 ft., scribed C1/4 S4 BT.

DIAGRAM

T7S R26E
C 1/4
S4

2008
PLS 49865

Measurements to accessories taken with Topcon Hyper II GPS and tape measure.

I hereby certify that the above corner point was perpetuated as shown hereon on October 19, 2008 and revisited on August 14, 2013.

Witness: D. Mitchell Ferguson, LSIT
David H. Herburger, Surv. Tech.

Office of Surveyor County of Morrow
State of Oregon. I hereby certify that the within instrument was filed in this office
for record on the 16th day of April, 2014

Steph K. Hallock by _____
County Surveyor Deputy

REGISTERED
PROFESSIONAL
LAND SURVEYOR

OREGON
JULY 13, 1999
KENNETH H. DELANO JR.
49865
RENEWS: 1/1/2016

See Grant County Map of Survey No. 1985
See Morrow County Map of Survey No. 2013-1687D