


CERTIFIED RECORD OF LAND CORNER MONUMENTATION

T.7S., R.26E., INDEX C-13

History of original corner establishment:

This corner was originally established by A.F. York under G.L.O. contract No. 309, dated Nov. 18, 1878. Survey General notes state:

Set stone 13x11x7 for 1/4 sec. cor. From which
A yellow pine 38 in. in dia. bears N59°W, 49 lks dist.
A yellow pine 15 in. in dia. bears N15°E, 70 lks dist.

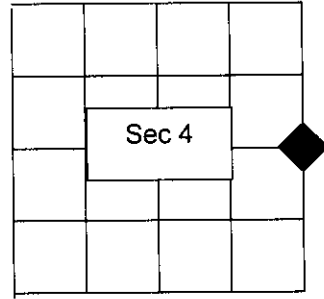

Description of corner evidence found:

Found a 12x10x7 stone, no visible marks, from which:
A 30" burnt pine snag, blaze face burnt off, with U.S.F.S. location poster, bears N59°W, 32.3 ft. (Record N59°W, 32.3 ft.)
A chopped off pine stump with lower portion of blaze face visible, bears N15°E, 46.2 ft. (Record N15°E, 46.2 ft.)

Description of monument and accessories I establish to perpetuate the original location of this corner:

At the location of found stone, Set a 2-1/2" dia. x 30" aluminum pipe monument w/3" dia. cap stamped as shown in the DIAGRAM, 20" in the ground, from which:

- A 8" dia. Ponderosa Pine bears N41°30'W, 43.3 ft., scribed 1/4 S4 BT.
- A 6" dia. Ponderosa Pine bears N1°00'E, 12.6 ft., scribed X BT.
- A 8" dia. Ponderosa Pine bears S19°45'E, 13.2 ft., scribed 1/4 S3 BT.
- A 12" dia. Ponderosa Pine bears S25°30'W, 19.9 ft., scribed 1/4 S4 BT.

DIAGRAM

T7S R26E
1/4
S4 | S3

2008
PLS 49865

Measurements to accessories taken with Topcon Hyper II GPS and tape measure.

I hereby certify that the above corner point was perpetuated as shown hereon on October 22, 2008 and revisited on August 14, 2013.

Witness: D. Mitchell Ferguson, LSIT
David H. Herburger, Surv. Tech.

Office of Surveyor County of Morrow
State of Oregon. I hereby certify that the within instrument was filed in this office
for record on the 16th day of April, 2014

Stephen K. Waldock by _____
County Surveyor Deputy

REGISTERED
PROFESSIONAL
LAND SURVEYOR

OREGON
JULY 13, 1999
KENNETH H. DELANO JR.
49865

RENEWS: 1/1/2016

See Grant County Map of Survey No. 1985
See Morrow County Map of Survey No. 2013-1687D