


CERTIFIED RECORD OF LAND CORNER MONUMENTATION

T.7S., R.26E., INDEX C-7

History of original corner establishment:

This corner was not originally established.

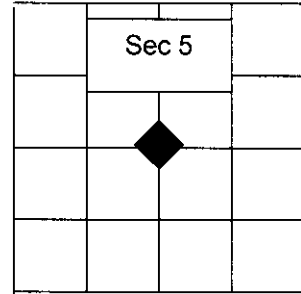

Description of corner evidence found:

Description of monument and accessories I establish to perpetuate the original location of this corner:

At the calculated position, Set a 2-1/2" dia. x 30" aluminum pipe monument w/3" dia. cap stamped as shown in the DIAGRAM, 12" in the ground, raised a 1.5' high x 3' dia. mound of stone, from which:

- A 10" dia. Douglas Fir bears N27°34'W, 26.33 ft., scribed C1/4 S5 BT.
- A 12" dia. Douglas Fir bears N65°02'E, 30.12 ft., scribed C1/4 S5 BT.
- A 8" dia. Ponderosa Pine bears S57°18'E, 14.09 ft., scribed C1/4 S5 BT.
- A 12" dia. Douglas Fir bears S29°31'W, 35.35 ft., scribed C1/4 S5 BT.

DIAGRAM

T7S R26E
C 1/4
S5

2008
PLS 49865

Measurements to accessories taken with Topcon Hyper II GPS and tape measure.

I hereby certify that the above corner point was perpetuated as shown hereon on October 22, 2008 and revisited on August 14, 2013.

Witness: D. Mitchell Ferguson, LSIT
David H. Herburger, Surv. Tech.

Office of Surveyor County of Morrow
State of Oregon. I hereby certify that the within instrument was filed in this office
for record on the 16th day of April, 2014

Stephen K. Haddock by _____
County Surveyor Deputy



See Grant County Map of Survey No. 1985

See Morrow County Map of Survey No. 2013-1687D