


CERTIFIED RECORD OF LAND CORNER MONUMENTATION

T.7S., R.26E., INDEX C-9

History of original corner establishment:

This corner was originally established by A.F. York under G.L.O. contract No. 309, dated Nov. 18, 1878. Survey General notes state:

Set stone 13x13x9 for 1/4 sec. cor. From which
A pine 36 in. in dia. bears N60°W, 36 lks dist.
A yellow pine 18 in. in dia. bears N35°E, 69 lks dist.

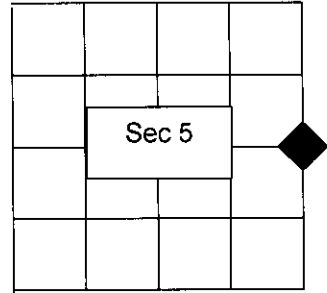

Description of corner evidence found:

Found a 12x12x9 stone, no visible marks, in a mound of stone, from which:
A 36" downed pine snag, with "1/4 S" visible, bears N64°19'W, 23 ft. (Record N60°W, 23.7 ft.)
A decaying, fallen pine stump and blaze face, no scribing visible, bears N29°17"E, 48.1 ft. (Record N35°E, 45.5 ft.)

Description of monument and accessories I establish to perpetuate the original location of this corner:

At center of the found mound of stone, Set a 2-1/2" dia. x 30" aluminum pipe monument w/3" dia. cap stamped as shown in the DIAGRAM, 24" in the ground, raised a 0.5' high x 3' dia. mound of stone, from which:

- A 10" dia. Juniper bears N3°30'W, 14.8 ft., scribed 1/4 S5 BT.
- A 12" dia. Ponderosa Pine bears N2°00'E, 59.7 ft., scribed 1/4 S4 BT.
- A 10" dia. Juniper bears N66°15'E, 85.6 ft., scribed 1/4 S4 BT.
- A 8" dia. Ponderosa Pine bears S62°00'W, 88.4 ft., scribed 1/4 S5 BT.

DIAGRAM

T7S R26E
1/4
S5 | S4

2008
PLS 49865

Measurements to accessories taken with Topcon Hyper II GPS and tape measure.

I hereby certify that the above corner point was perpetuated as shown hereon on October 19, 2008 and revisited on August 14, 2013.

Witness: D. Mitchell Ferguson, LSIT
David H. Herburger, Surv. Tech.

Office of Surveyor County of Morrow
State of Oregon. I hereby certify that the within instrument was filed in this office
for record on the 16th day of April, 2014

Stephen K. Haddock by _____
County Surveyor Deputy



See Grant County Map of Survey No. 1985
See Morrow County Map of Survey No. 2013-1687D