
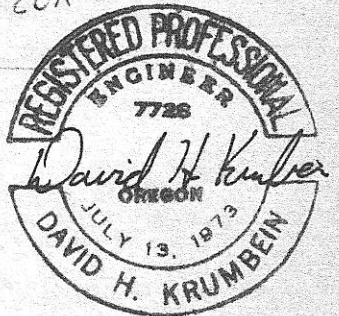


A-17-K

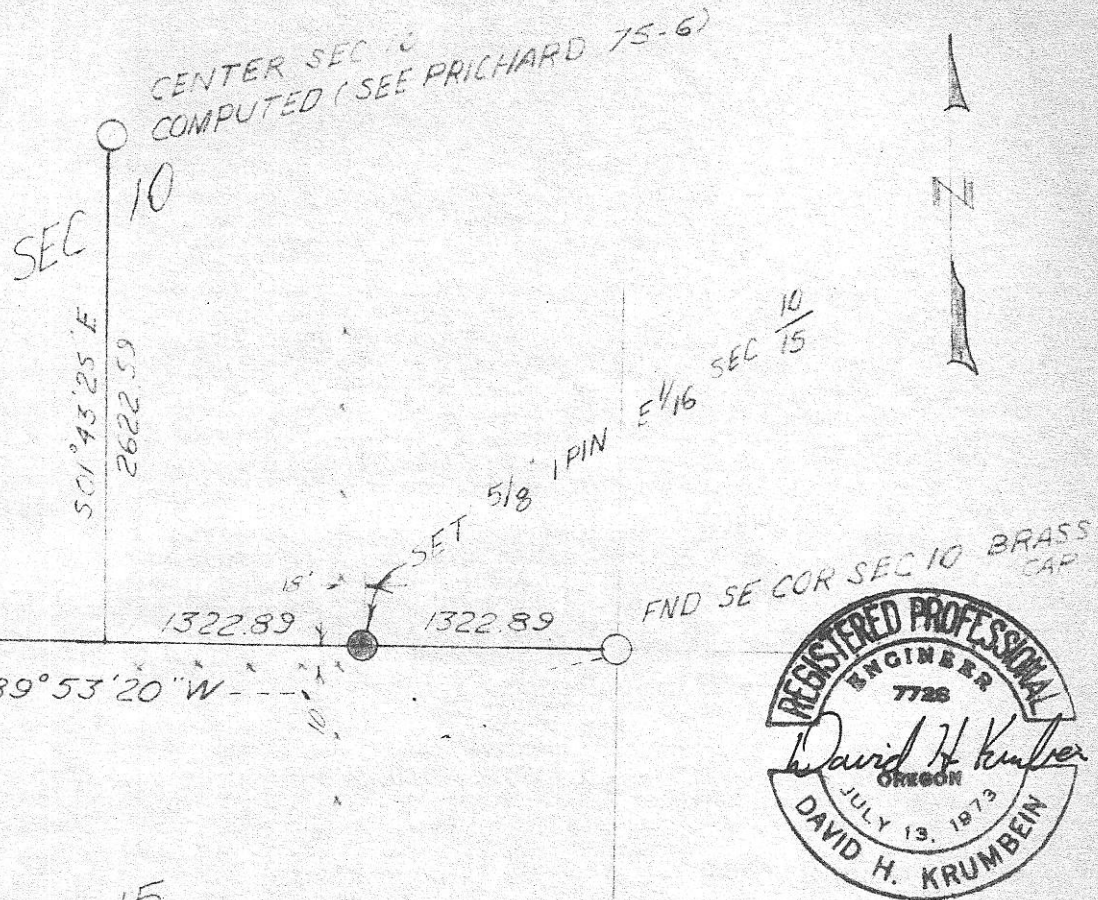

SEC 15

NOTE: BEARINGS ARE BASED UPON PLAT OF PORT OF MORROW FOOD PROCESSING, PARK, THOSE SHOWN ARE TRUE.

KRUMBEIN ENGINEERING CO. ENGINEERS-SURVEYORS-PLANNERS 216 SE 1 ST PENDLETON OREGON	SCALE 1"=1000'
	DATE 3 NOV 75
SURVEY FOR: BOB SICART E $\frac{1}{16}$ SEC $\frac{10}{15}$ TAN. R25E. W.M.	DRN BY JLC
	CHKD BY JHK
	DRNG. NO 75-07A