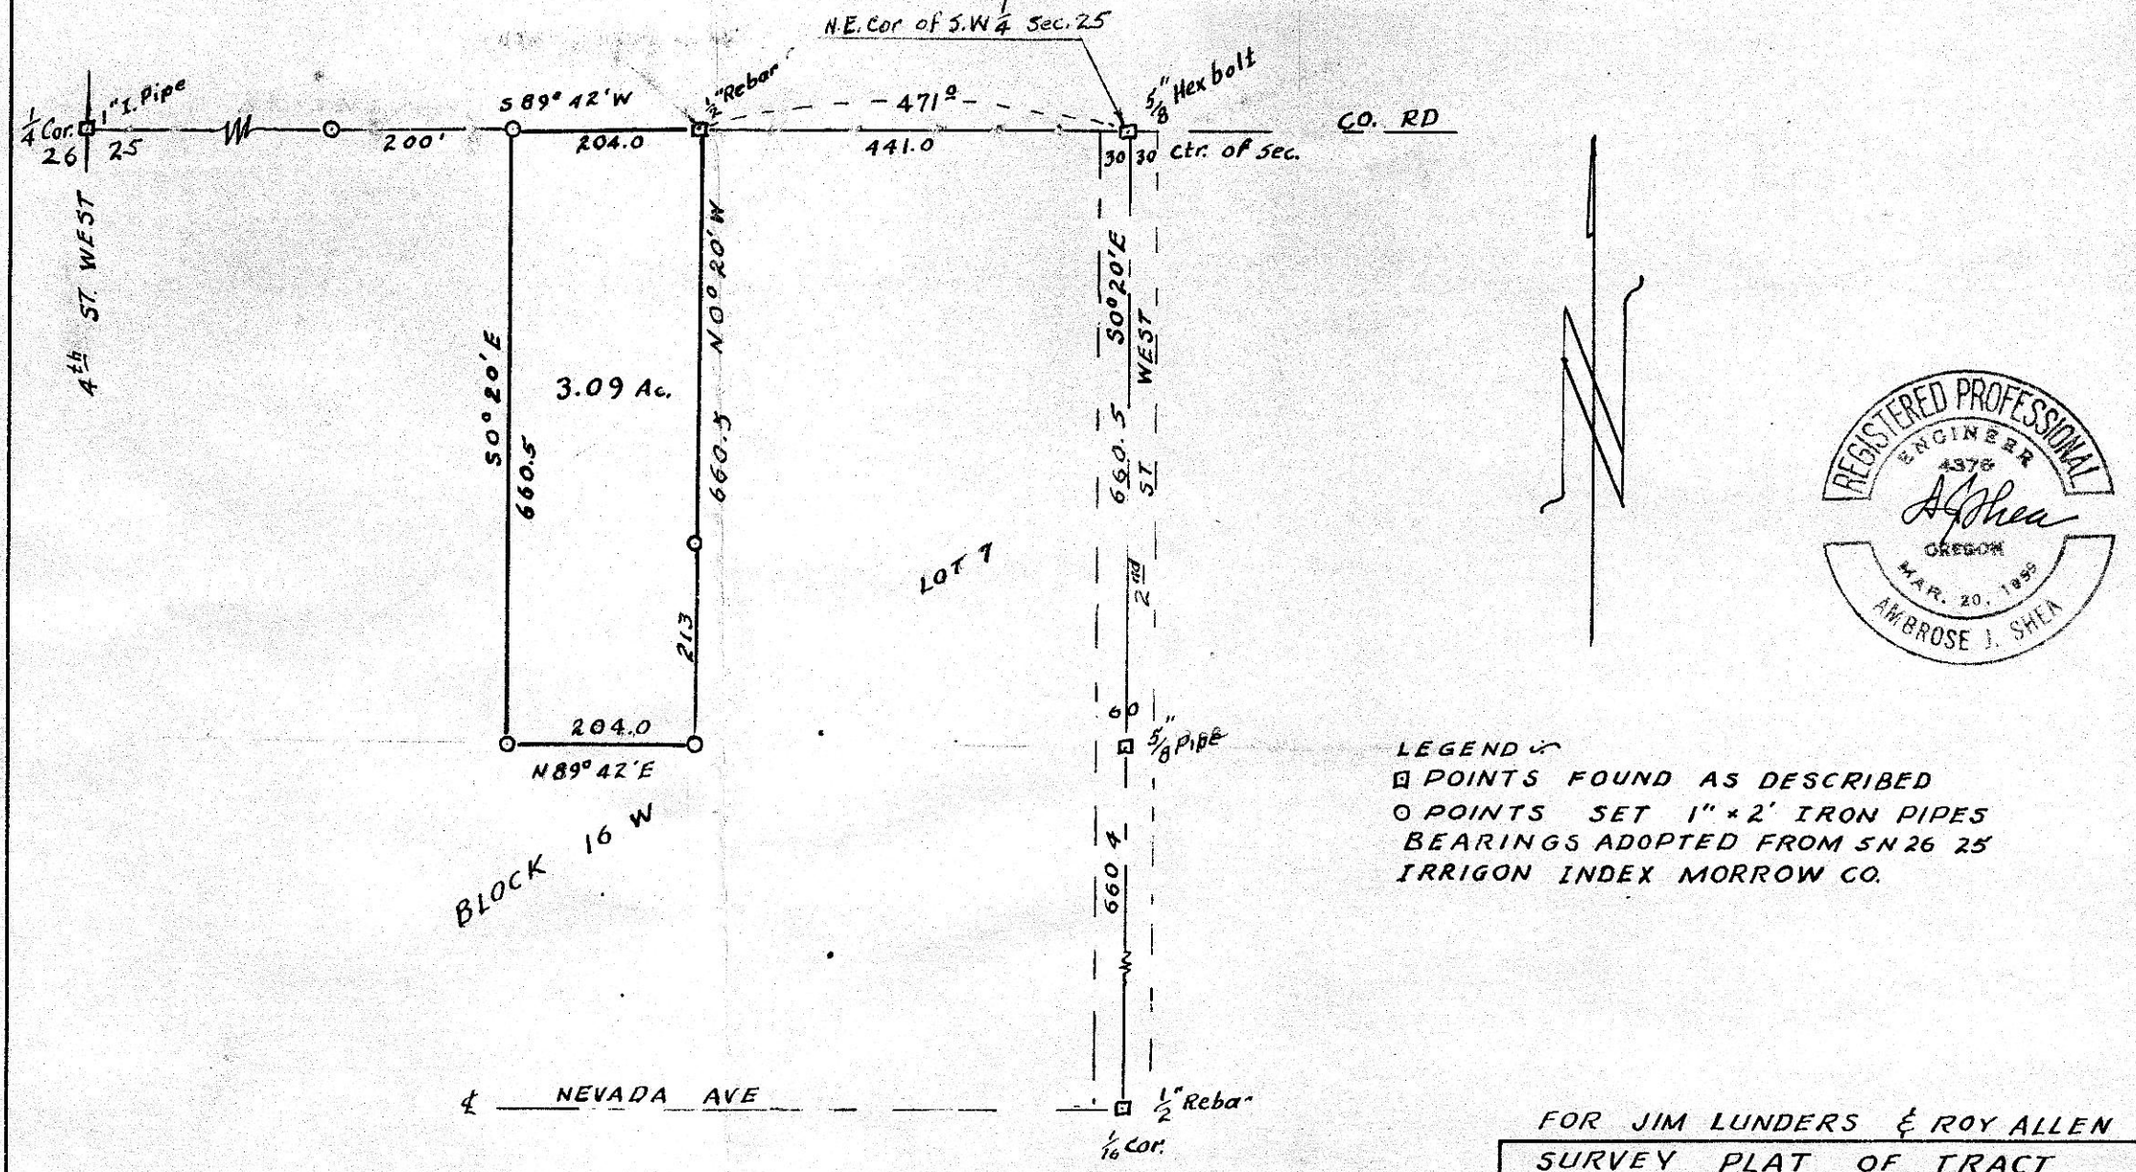

REGISTERED PROFESSIONAL ENGINEER
4376
A. J. Shea
OREGON
MAR. 20, 1959
AMBROSE J. SHEA

LEGEND :-
- ⊡ POINTS FOUND AS DESCRIBED
- ○ POINTS SET 1" × 2' IRON PIPES

BEARINGS ADOPTED FROM SN 26 25 IRRIGON INDEX MORROW CO.

FOR JIM LUNDERS & ROY ALLEN

SURVEY PLAT OF TRACT
IN NE 1/4 / SW 1/4 SEC. 25, T 5N., R 26., E.W.M.
MORROW CO. ORE.
SCALE 1" = 200' 12-9-75

A-36-K-10

#36-K

A-#36-K