


T.5N R.26  
T.5N R.27

South Main (highway)

DIVISION ST

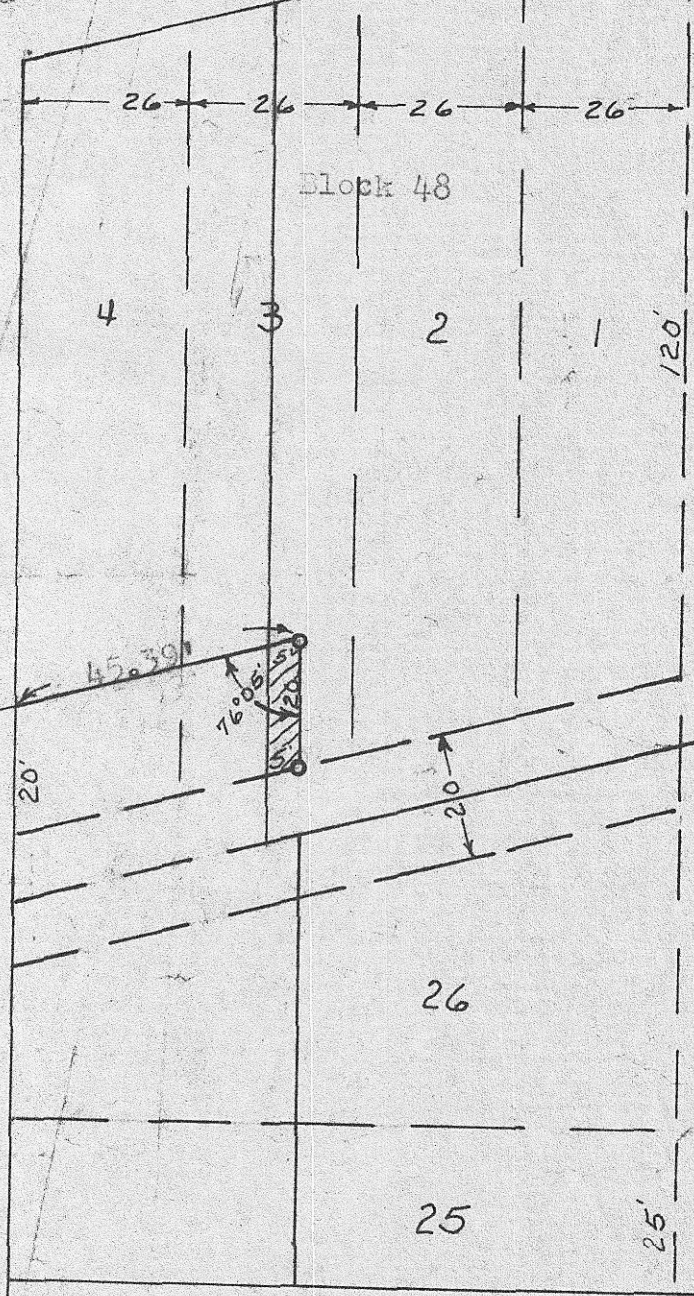

Vacated

6th St

REGISTERED  
OREGON  
LAND SURVEYOR

Ralph P. Thompson

MAY 13, 1960  
RALPH P. THOMPSON  
506

"o" Designates I.P.set.  
"c" Designates conc.nail set.

Property Survey for  
Arthur Dickman  
the west 5 ft. of the south 20  
ft. of the east 1/2 of lot 3  
Block 48, Irrigon, Oregon

Date: 8/10/70    Scale: 1"=30'

Ralph Thompson  
Registered Land Surveyor  
P.O. Box 1082  
Pendleton, Oregon

30'    30'

24 19  
25 30  
Fnd. 5/8 1/2

T4NR 25E Sec 19

A-67-K-18