

E.W. BOARDMAN AVE.




CL=89.97  
 ARC=90.00  
 RAD=970.00  
 $\Delta=518'58''$   
 $T=45.03$

N18°31'54"W, 106.77  
 concrete retaining wall


LOT #3

2nd. Addition to Boardman  
 301 N.W. Boardman Avenue.

N18°12'56"W, 106.77

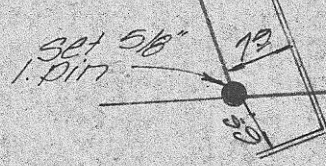

N.87°25"E. 81.37

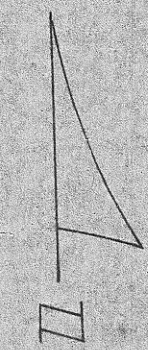

A-159 K

REGISTERED  
 PROFESSIONAL  
 LAND SURVEYOR  
 David H. Krumbain  
 OREGON  
 JULY 17, 1948  
 DAVID H. KRUMBAIN  
 933

<b>K</b> KRUMBAIN ENGINEERING CO. ENGINEERS - SURVEYORS - PLANNERS 221 S. Main, Pendleton, Oregon	SCALE 1" = 20'
	DATE MAY 26, 78
SURVEY FOR <b>JOLIN LIASCALL</b> Lot 3, 2nd. Addition to Boardman Sec. 8, T4N R26E W.M.	DRN. BY J.L.C.
	CKD. BY DLK
	DRNG. NO. 1552A