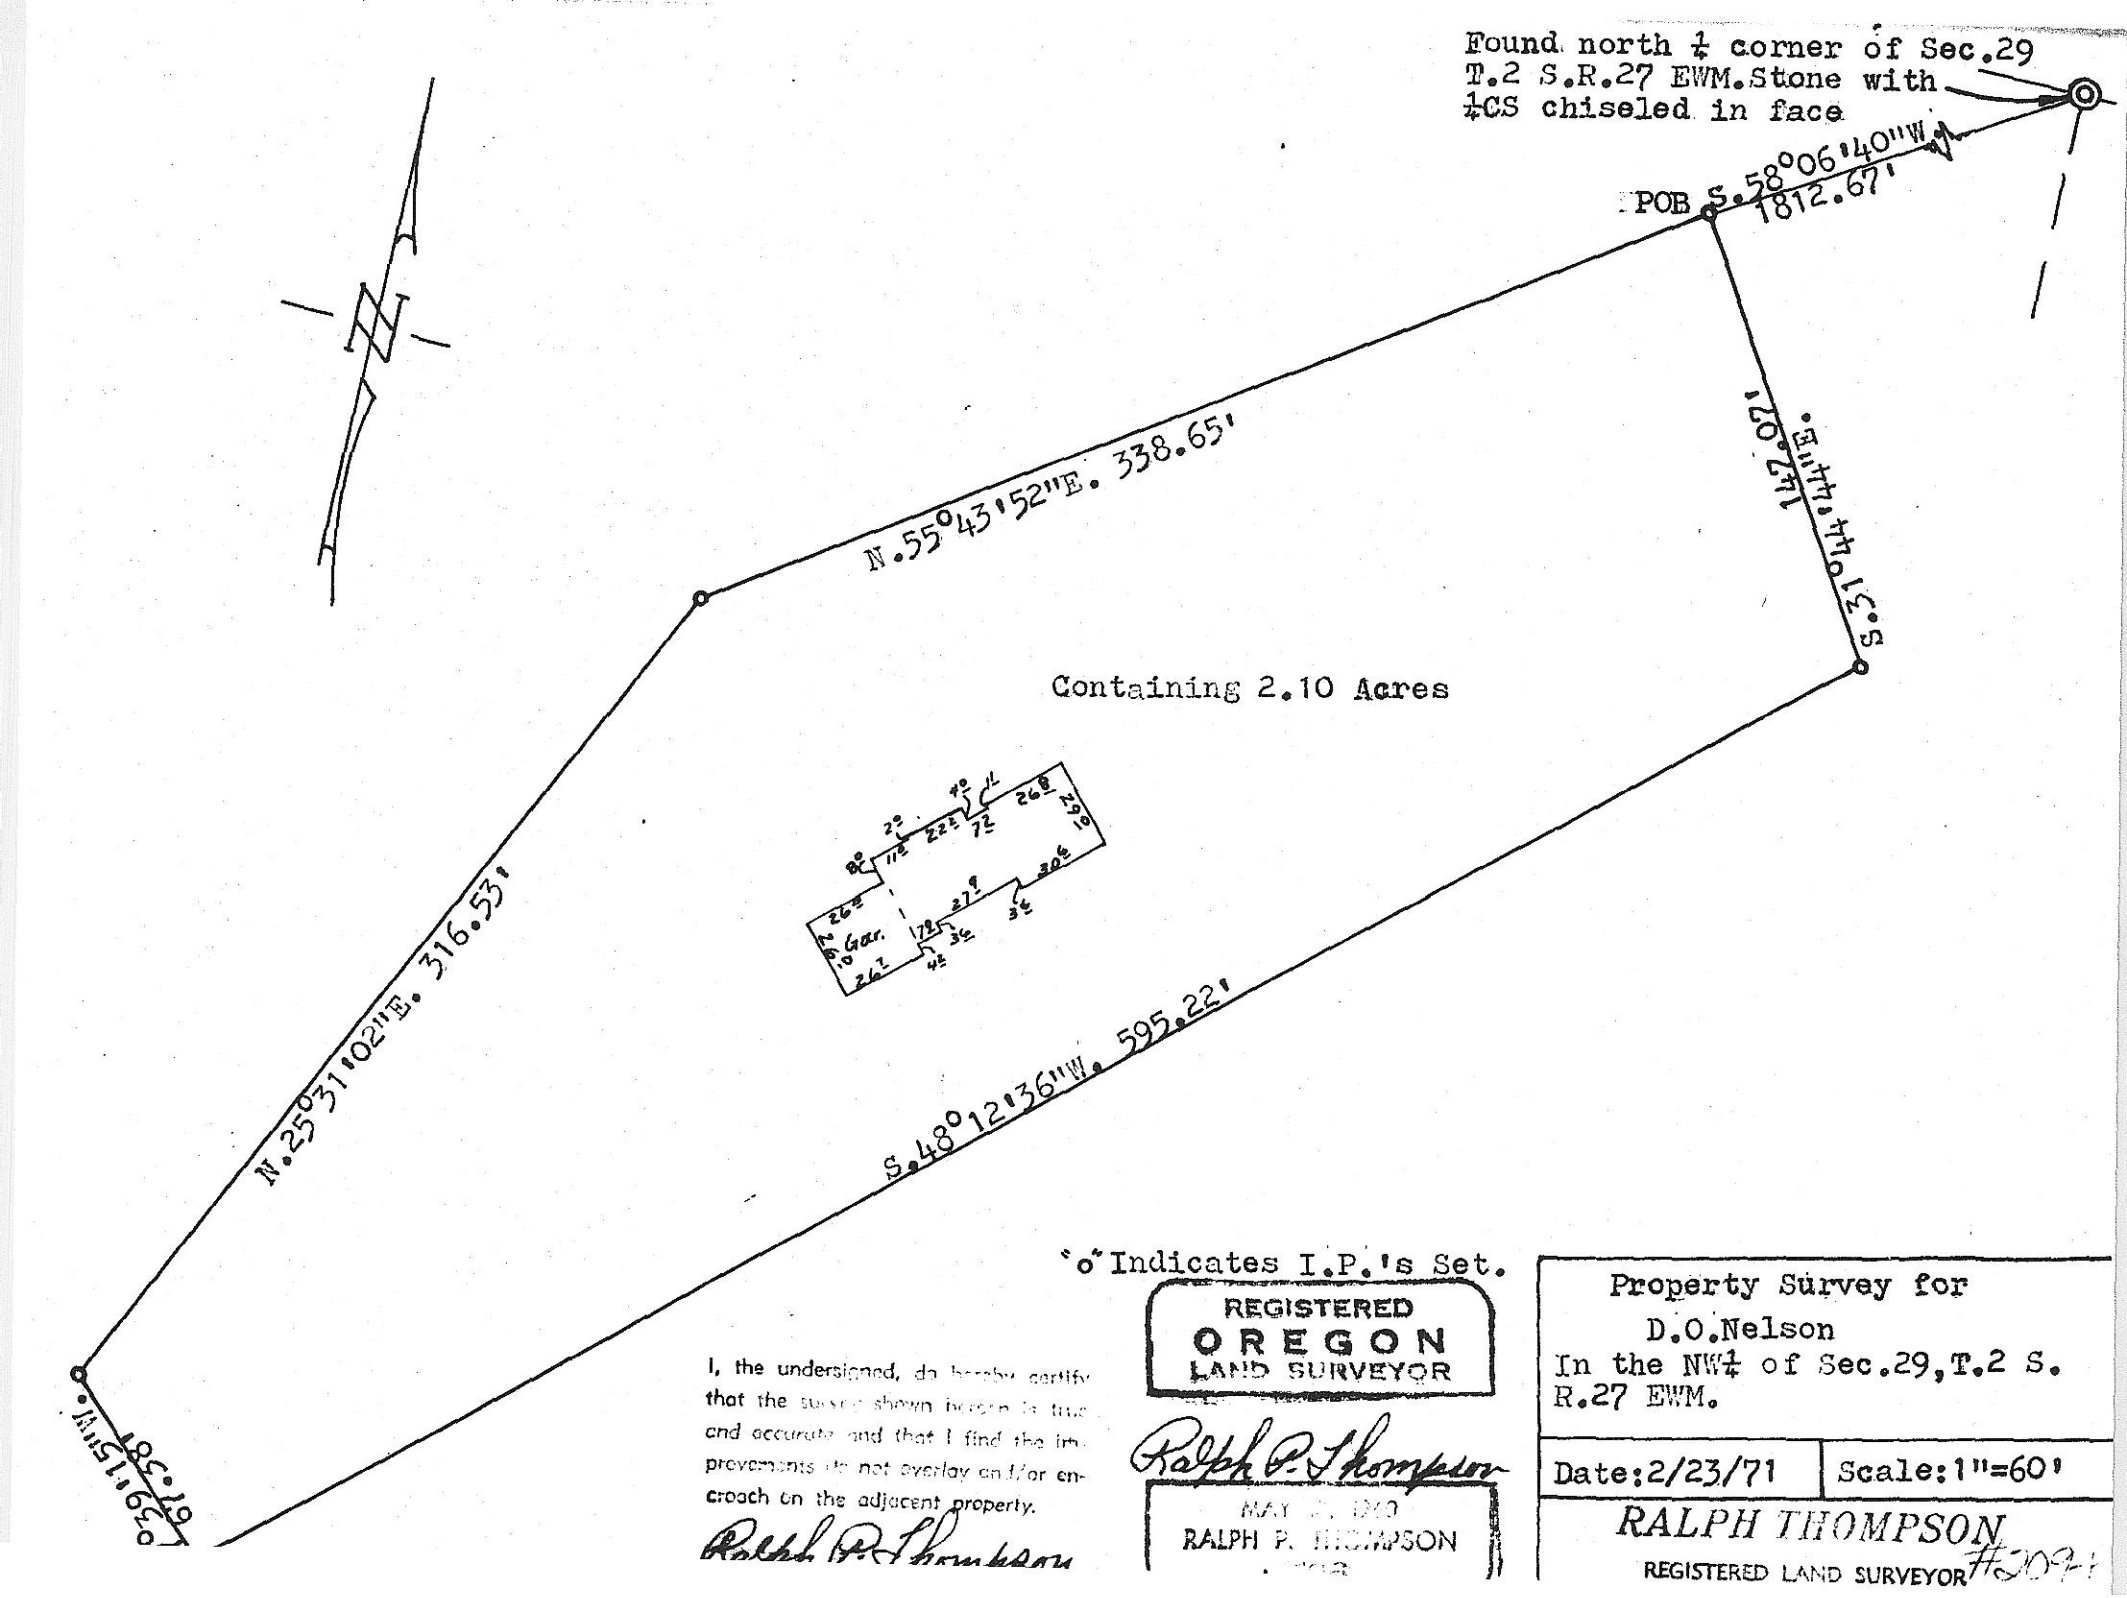

"o" Indicates I.P.'s Set.

I, the undersigned, do hereby certify that the survey shown hereon is true and accurate and that I find the improvements do not overlay and/or encroach on the adjacent property.

Ralph P. Thompson

REGISTERED OREGON LAND SURVEYOR

Ralph P. Thompson

MAY [illegible] 1970

RALPH P. THOMPSON

Property Survey for
D.O.Nelson
In the NW¼ of Sec.29, T.2 S. R.27 EWM.

Date: 2/23/71	Scale: 1"=60'

RALPH THOMPSON
REGISTERED LAND SURVEYOR #2094