

UTAH AVE

(350') 329.81

FND NAIL

FND 3/4" IR

90° 09'

30'



BLOCK 2 W
SEC. 25, T5N, R26E, W.M.

300.00'

DIVISION ST.

1951.35


RECEIVED BY

Joe Conforth

4-10-79

by S. Barth

NO.

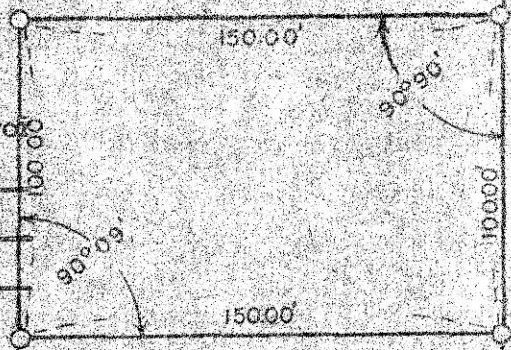

REGISTERED
PROFESSIONAL
LAND SURVEYOR

L. Dennis Edwards

OREGON

G. DENNIS EDWARDS
951

SURVEY FOR JOE CONFORTH
LOCATION IN BLOCK 2W NE 1/4 OF
SEC. 25, T5N, R 26E, WM., MORROW CO., ORE.

● MONUMENTS FOUND

SCALE: 1" = 60'

○ IRON RODS SET

(000) OF RECORD

JOB NO. S7902039

EDWARD'S SURVEYING

P. O. Box 763

567-3336

Hermiston, Ore

FND
RR SPIKE
E 1/4 COR. SEC-25,
T5N, R26E, WM

AE 210-14