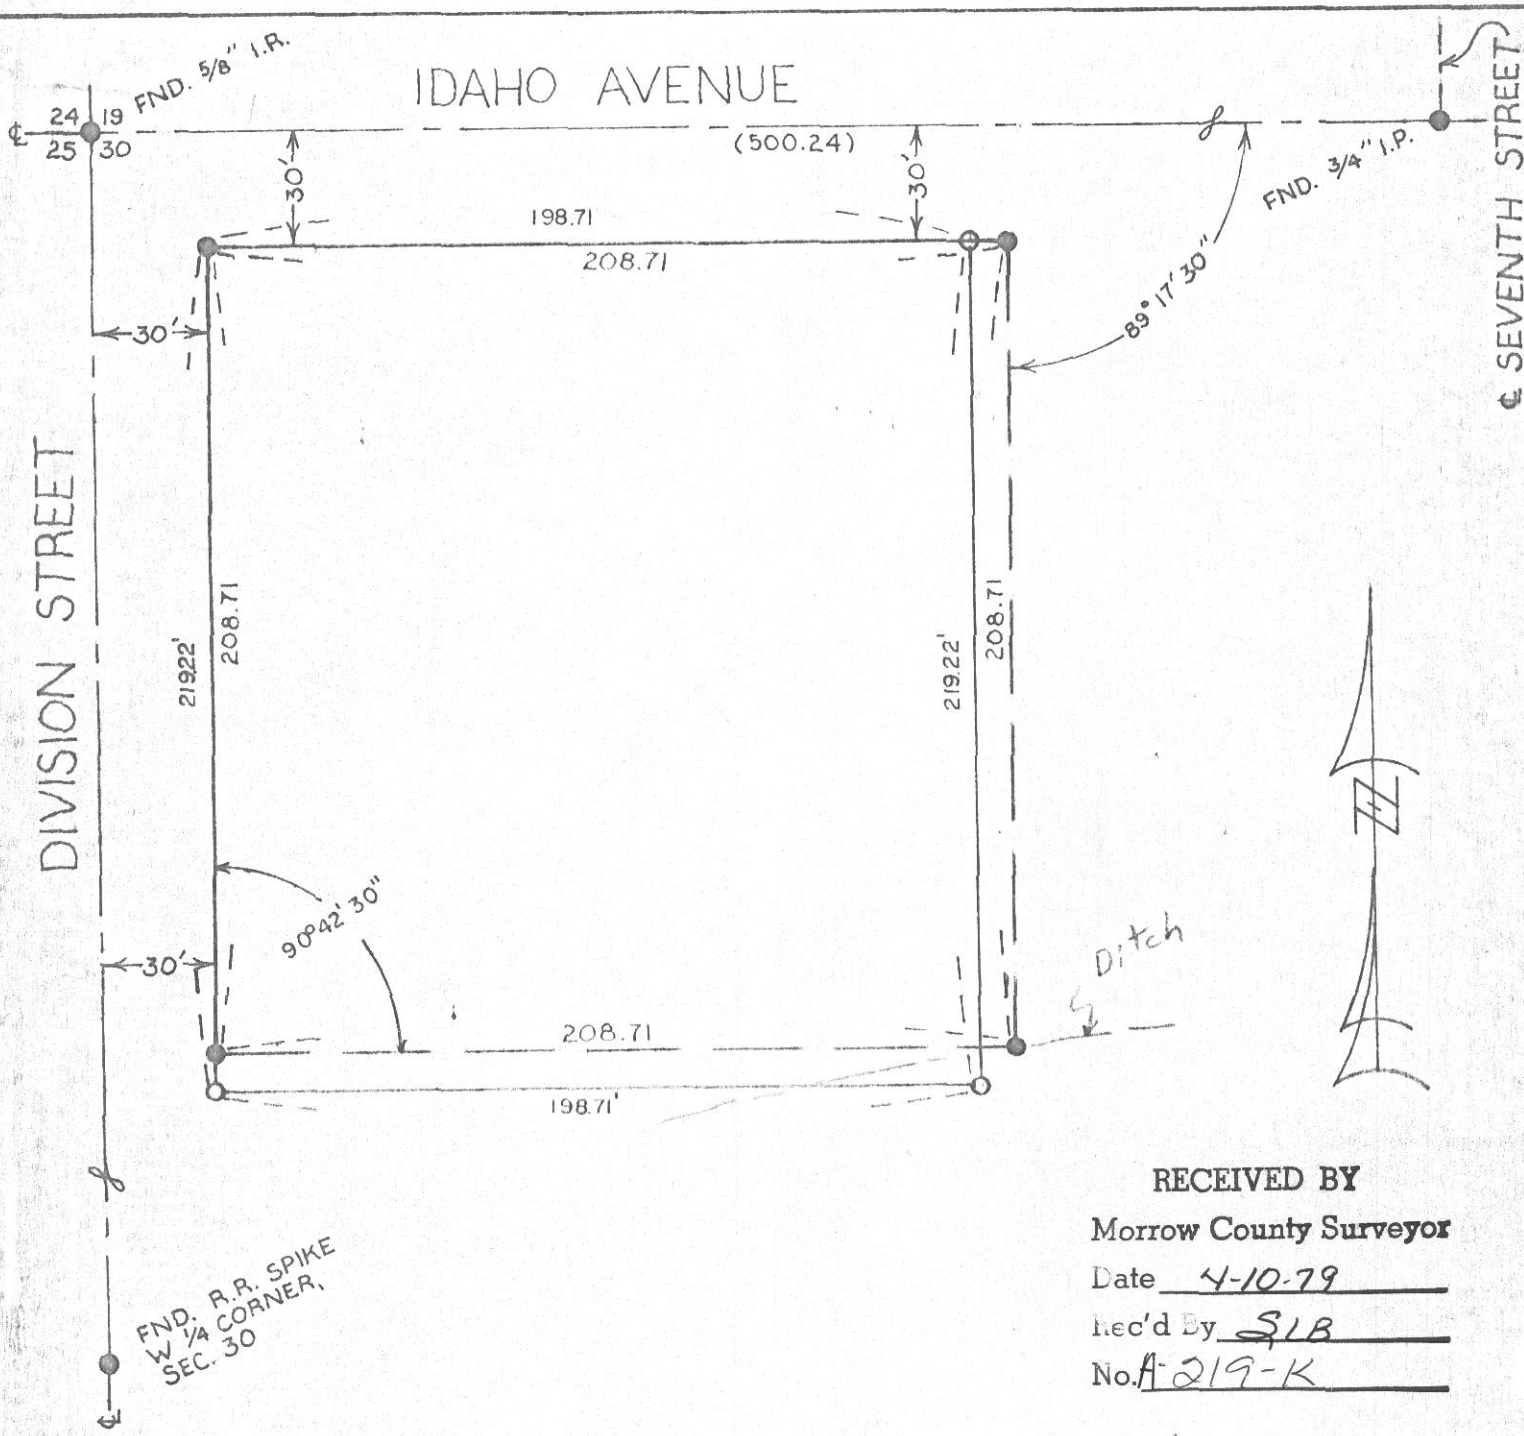

RECEIVED BY
Morrow County Surveyor
Date 4-10-79
Rec'd By SLB
No. A-219-K

REGISTERED
PROFESSIONAL
LAND SURVEYOR
G. Dennis Edwards
OREGON
JULY 19, 1971
G. DENNIS EDWARDS
951

SURVEY FOR MIKE LINNELL
REVISED FOR JOE IRISH
LOCATION NW ¼ OF NW ¼ OF SEC. 30, T5N,
R27 E, W.M., MORROW COUNTY, OREGON

DATE: 8-31-77
REVISED 2/22/79

SCALE: 1" = 50'

● MONUMENTS FOUND

(000) OF RECORD

O ½" IRON RODS SET

JOB NO. S7708255-A

EDWARDS SURVEYING
567-3336
P. O. Box 763
Hermiston, Ore